High Prairie Survey Co.

Physical Address: 345 Comanche St.
Mail to: Box 384, Kiowa, CO 80117
Ph. 303-621-8672 - Fax 303-621-7749
www.highprairiesurvey.com

Job # 14051 Daisy Duke #1 Inv # 3021

High Prairie Surveying of Kiowa, Colorado has in accordance with a request from **Pronghorn Operating LLC** has determined the location of **Daisy Duke #1** to be **660 feet FNL**, and **1980 feet FWL**, (90° off Section lines) **of** SECTION **7**, Township **15s**, Range **44w** of the 6th Principal Meridian, **Cheyenne County**, Colorado.

Date: Staked on 03/12/2014 drawn on 03/13/2014

Re: Staked by Elijah Frane
Drawn: Drawn by Dustin Cotter

Basis of Elevation Spot: USGS BM = H 12, PID = JJ0627, H-Order = Third, V-Order = Code A, Stability = Unknown, P-DOP = 1.76, Sats = 10, US NAD 83 CO-C, Lat. = 38.88446, Long. = W102.35200, Elevation = 4322.74 gr. (us FT)

COLORADO LICENSED ELIJAH FRANE 38376 PROFESSIONAL LAND SURVEYOR 3-19-14

Notes: See Location Drawing for improvements within 500 ft of proposed well pad.
The ground elevation at staked location = 4252.61' gr.
This drawing does not represent a monumented survey or Land Survey Plat.
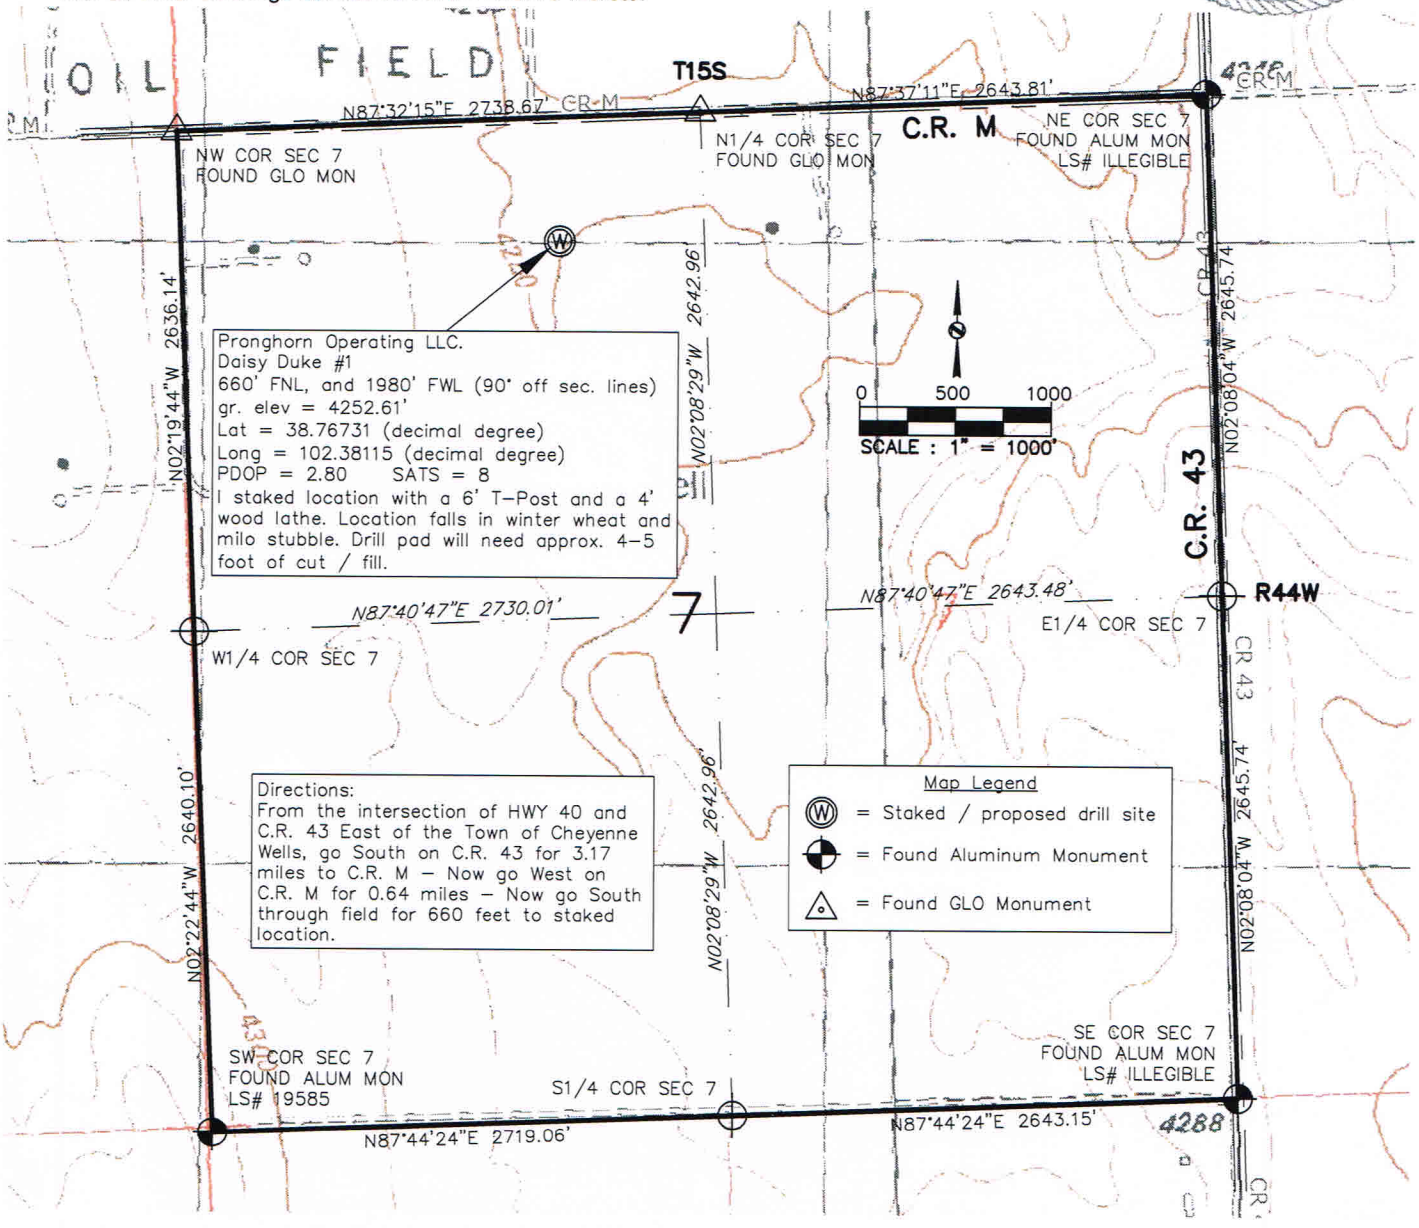
Basis of Bearing: Bearings were determined based on the North line of the NW1/4 of Section 7 to bear N87°32'15"E with all other bearings contained herein relative thereto.