



# MULTI-WELL PLAN

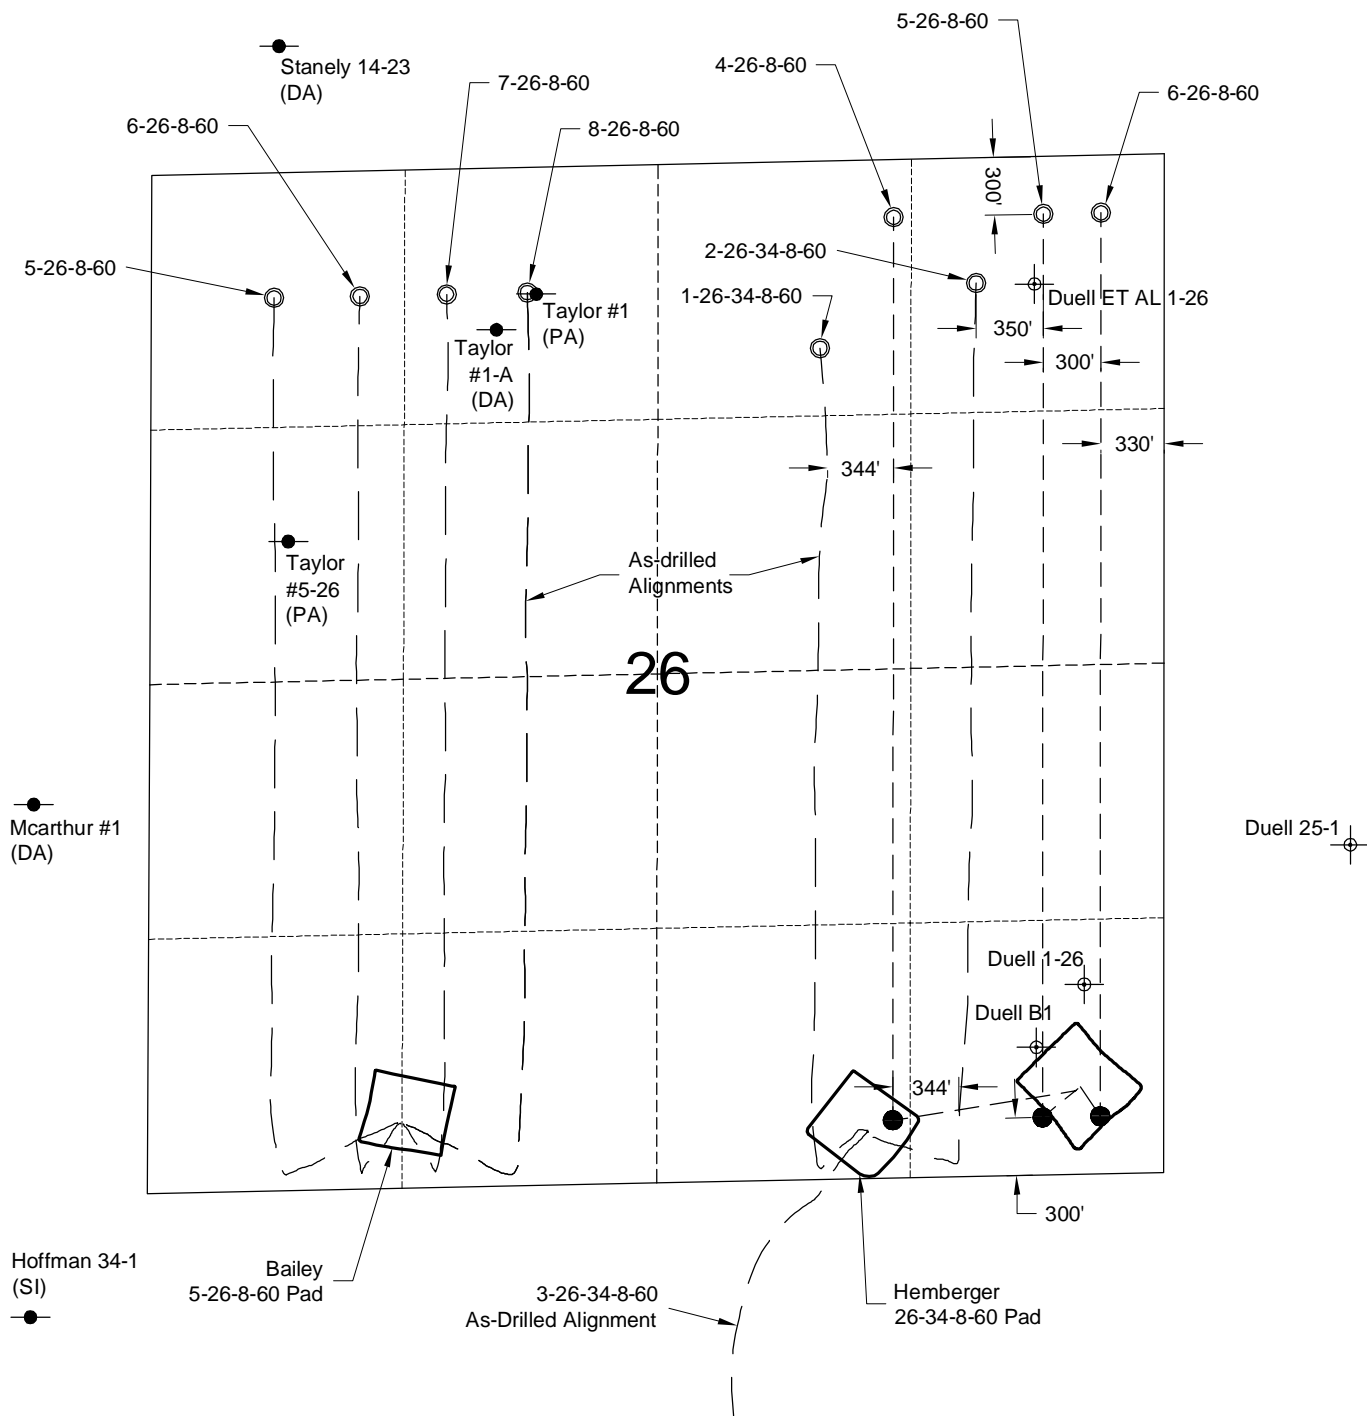

- Location Per COGCC. Not field located.
- Landing Point
- Horizontal Lateral TD

3/13/14

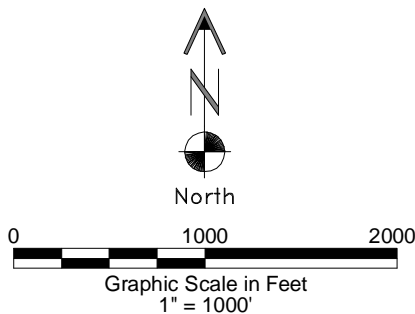

**GEO SURV**

LAND SURVEYING AND MAPPING  
LAFAYETTE - WINTER PARK  
Ph 303 666 0379 Fx 303 665 6320

**CARRIZO NIOBRARA LLC**  
**HEMBERGER 4-26-8-60 PAD**

**SE1/4 SE1/4 SECTION 26 T8N R60W**  
**6th PM WELD COUNTY COLORADO**