


8114 Northstar Drive
Windsor, Colorado 80528
P. 970-576-4641


THIS MAP DOES NOT REPRESENT A BOUNDARY SURVEY

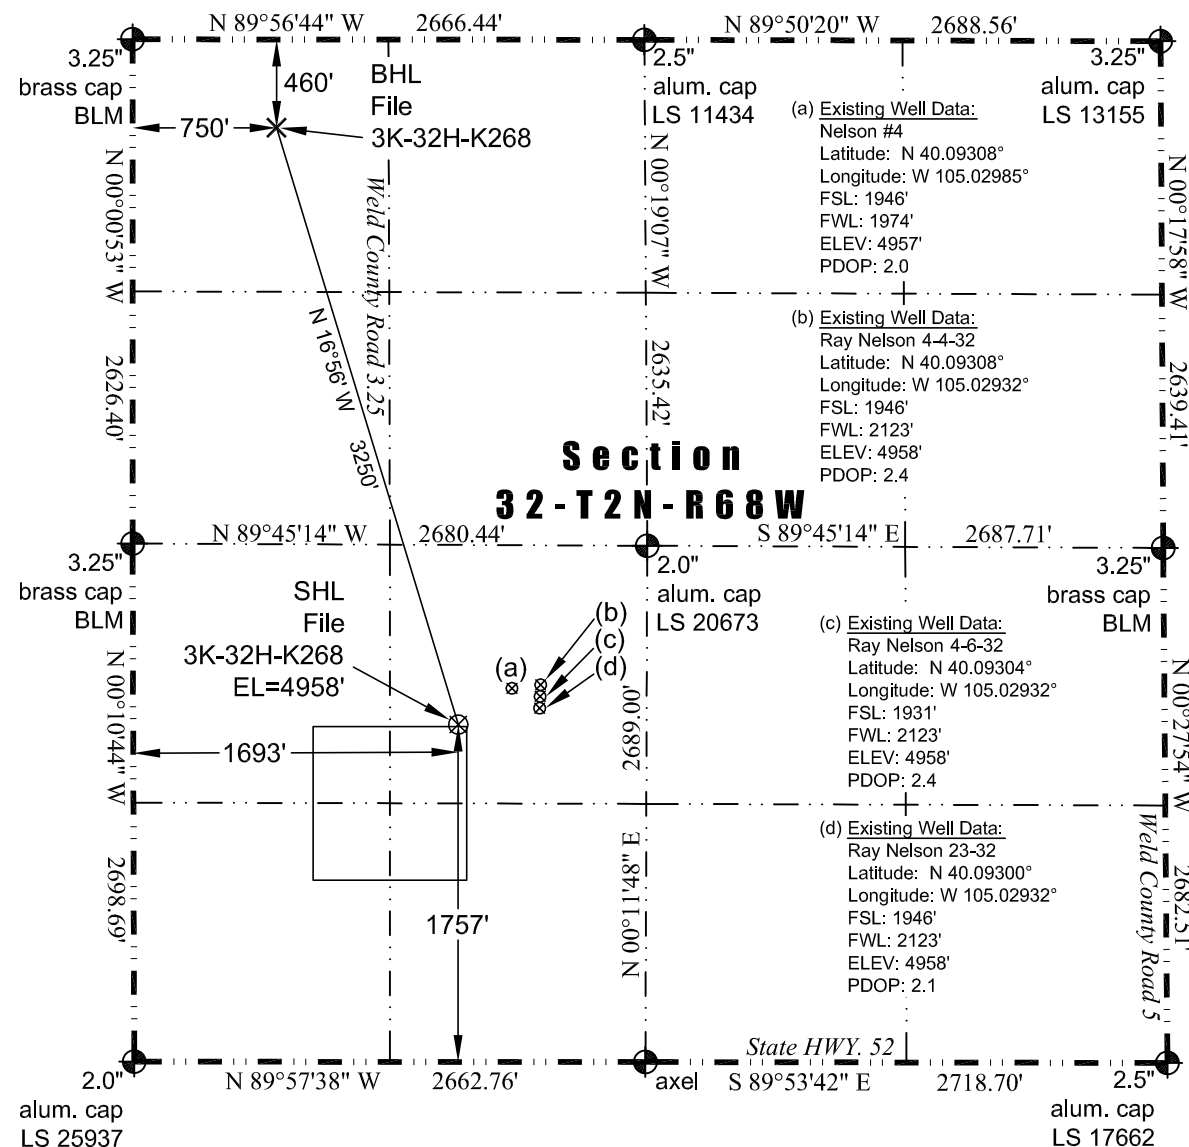

Scale 1" = 1000'

1000

approximate scale

LEGEND
 – found survey monument
 (c) – calculated dimension

In accordance with a request from Jay Knutson of EnCana Oil & Gas (USA) Inc., JR Land Surveying, LLC has determined the location of the **File 3K-32H-K268** well site to be SHL: 1757' FSL and 1693' FWL, (BHL: 460' FNL and 750' FWL), as measured at ninety (90) degrees from the section lines of Section 32, Township 2 North, Range 68 West of the 6th Principal Meridian, Weld County Colorado.

Latitude: N 40.09257° (BHL: 40.10111°)
Longitude: W 105.03086° (BHL: 105.03418°)
PDOP: 2.1

Building Unit: 532' southwest
Public Road: 368' west
Property Line: 356' west
Existing Well: Nelson #4, 338' northeast

Above Ground Utility: 350' west
Railroad: + 5,280'
Well Window: SHL is 10' outside
High Occupancy Building Unit: +5,280'

- 1) Bearings and distances based on NAD 83 Colorado North State Plane Coordinate, using RTK GPS observations taken 11/18/13 by operator John Rice
- 2) Conversion factor to ground (1.0002793972).
- 3) Elevations based on NAVD 88 GPS heights and Geoid 2003 corrections.
- 4) See Location Drawing for visible improvements within 500 feet of Pad Site.
- 5) The surface use is a cultivated field.

NOTICE: According to Colorado law you must commence any legal action based upon any defect in this W.L.C. within three years after you first discover such defect. In no event may any action based upon any defect in this W.L.C. be commenced more than ten years from this said date of the certification shown hereon.

I hereby certify that this Well Location Certificate was prepared by me or under my direct supervision on 11/18/2013 for and on behalf of EnCana Oil & Gas (USA) Inc. That it is not a Land Survey Plat or an Improvement Survey Plat and that it is not to be relied upon for establishment of fences, buildings, or other future improvement lines.

John Robert McGehee LS#38219
Well: File 3K-32H-K268 WLC