


WPX Energy Rocky Mountain LLC
BOSELY SG 311-27
GRAND VALLEY Field
SHL 596' FNL 1974' FWL (NE/4 NW/4) Section 27 T7S R96W 6th PM
BHL 468' FNL 159' FWL (NW/4 NW/4) Section 27 T7S R96W 6th PM
Garfield County Colorado

Formation Tops
(Measured Depths)

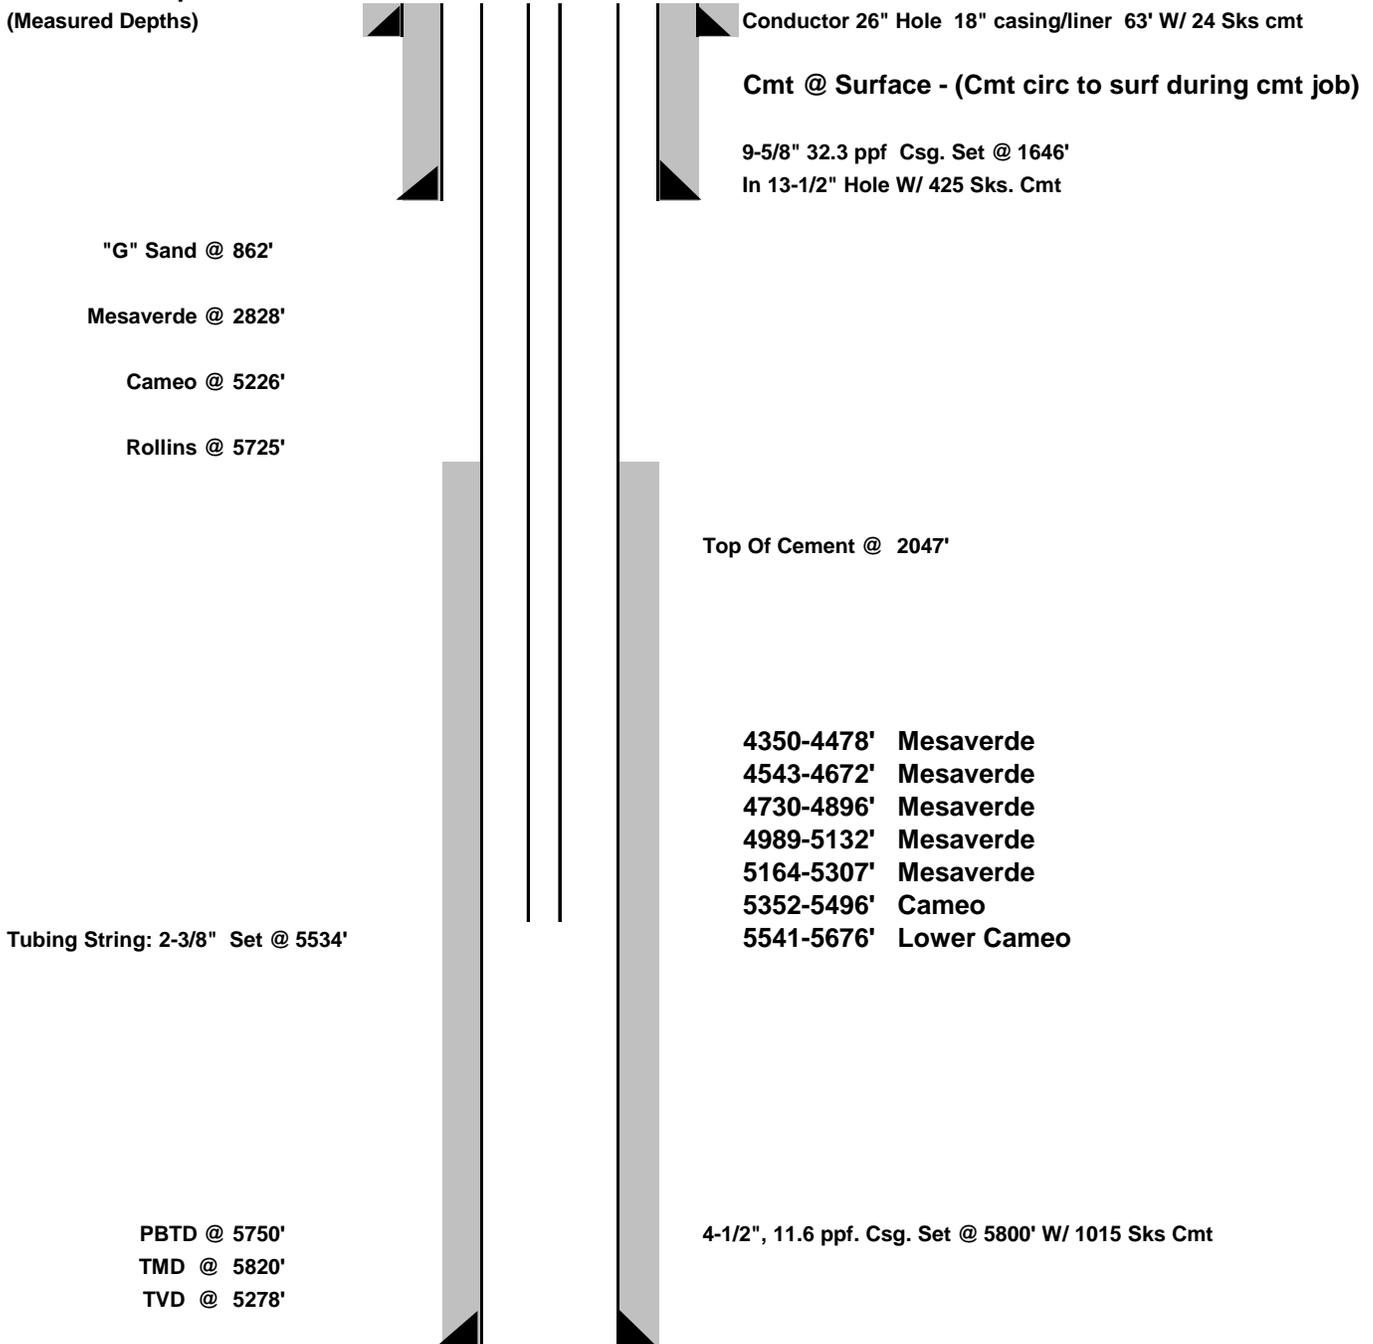

DATE CREATED: 3/19/2014

NOTE: THIS IS NOT TO SCALE.
****FINAL****