Attachment #1 – Wellbore Diagram

EnCana Oil & Gas (USA) Inc.

Well	:	**Geist 4-2-32**	
Field	:	**Wattenberg**	
County	:	**Weld County**	**State : Colorado**
Surface	:	**Lat: 40.18538**	**Long: -104.9189**
	:	**1586 FNL, 1229 FWL SW NW Sec 32 T3N R67W**	
API #	:	**05-123-26561**	
Grd Elev	:	**4802' GR**	**4817' KB**

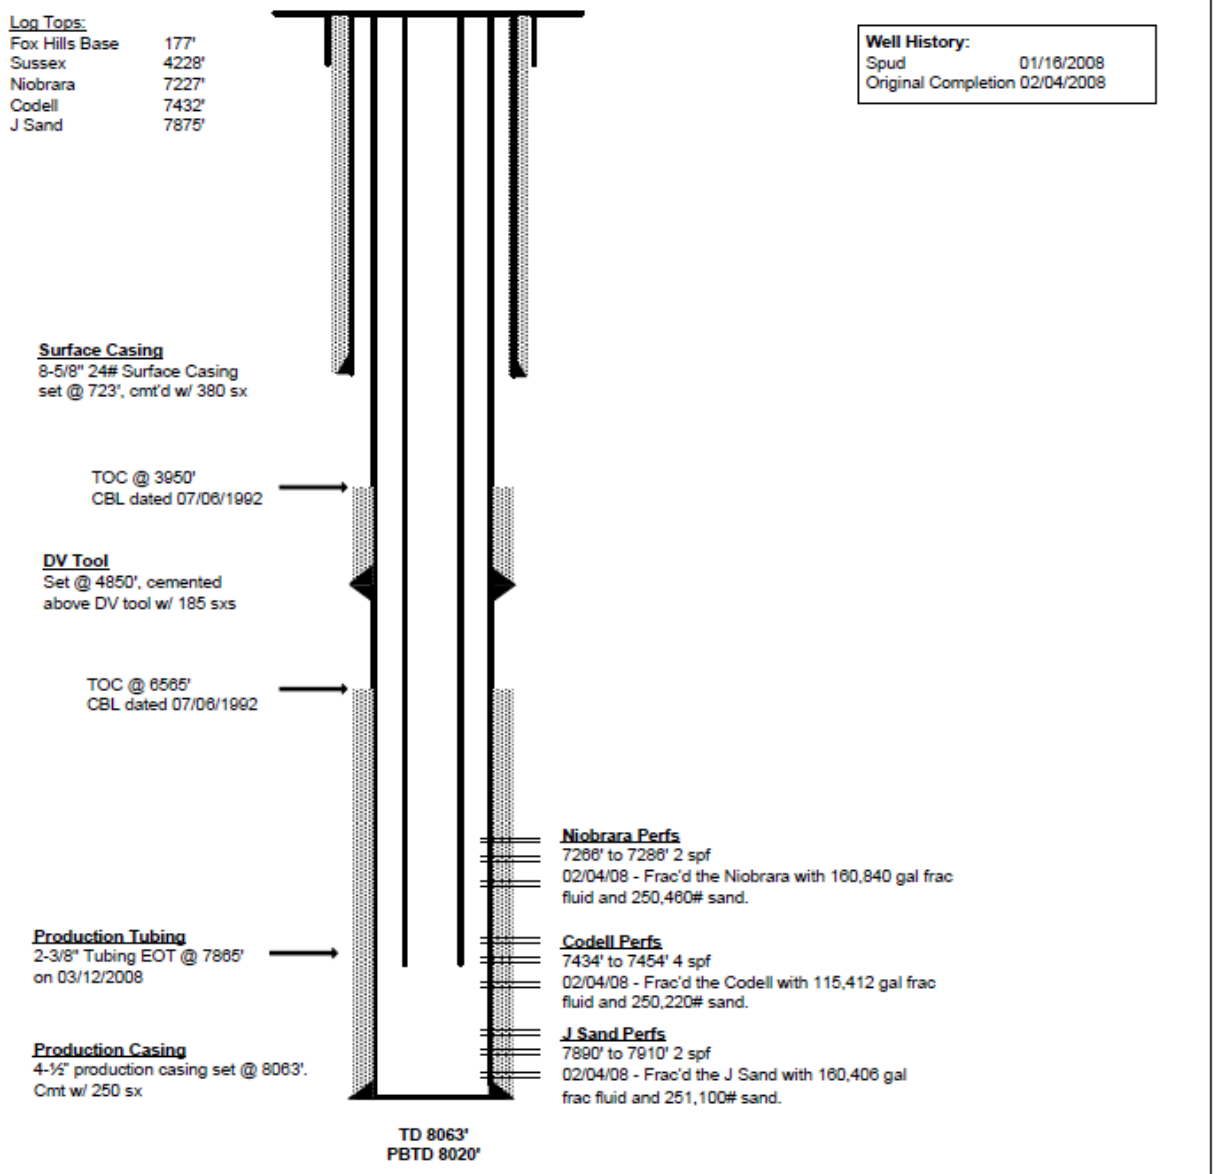

Drawn by:	Date:			
Torrey Mullen	03/18/2014			