




DRILLING COMPANY, INC.
WICHITA, KANSAS

Wellbore Diagram

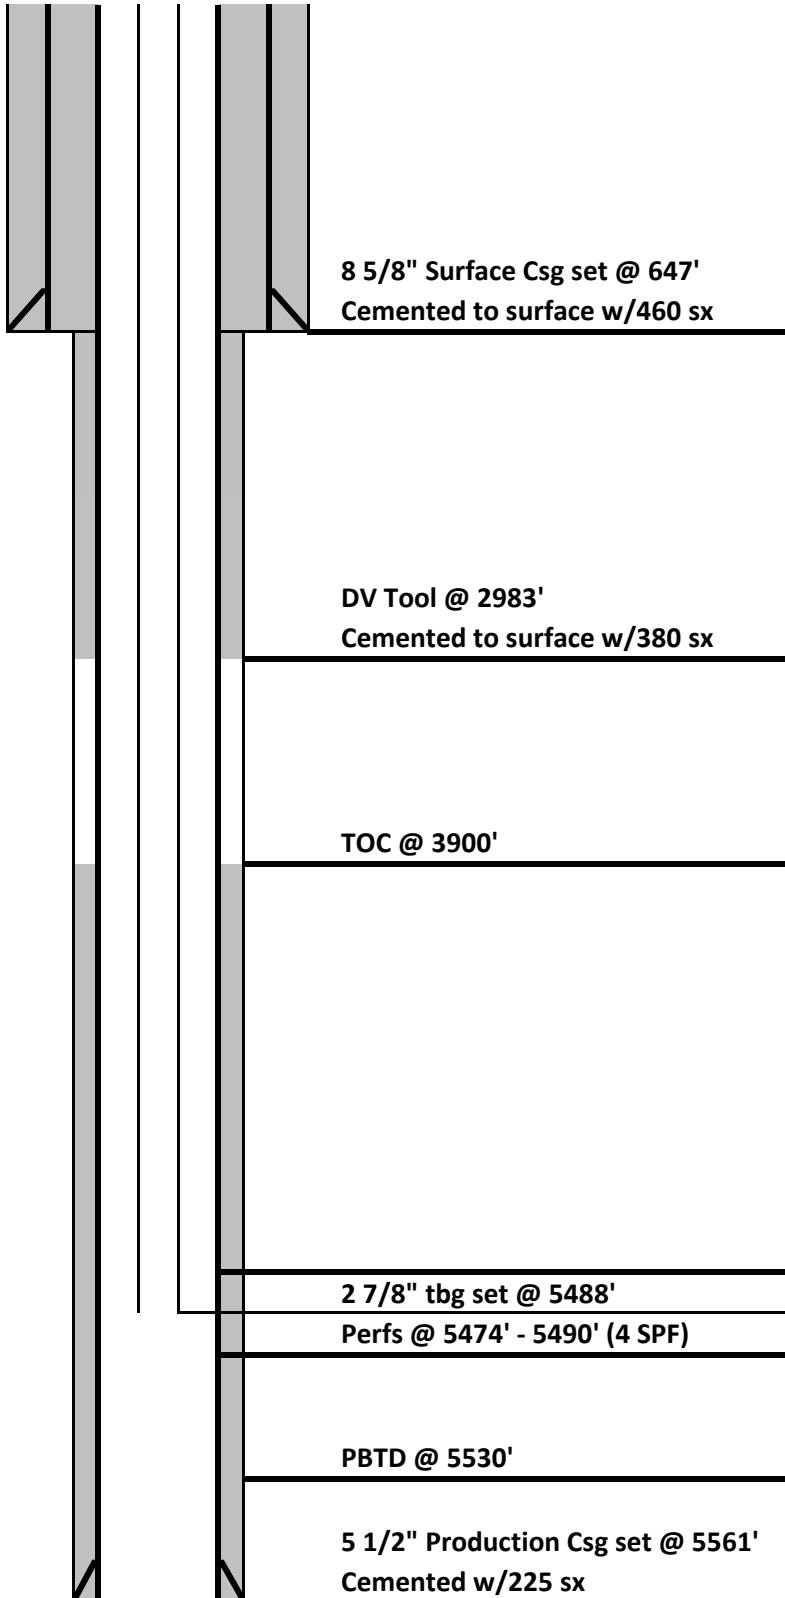

Date: 3/27/2014
 Well Name: Dickey A #1-14
 Location: 1927' FNL & 1119' FEL
Lot 7 14-16S-45W
 County: Cheyenne
 State: Colorado
 API: 05-017-07776-00
 Spud Date: 12/12/2013

Hole Size 12 1/4"
 Surface Casing: Set @ 647' (8 5/8")
 Cemented with: 460 sx
 Production Csg: Set @ 5561' (5 1/2")
 Cemented with: 225 sx

Log Tops:

Dakota	1560
Cheyenne	1653
Blaine	2418
Stone Corral	2969
Shawnee	4065
Heebner	4262
Lansing	4314
Marmaton	4665
Fort Scott	4748
Cherokee	4804
Atoka	4930
Morrow	5060
Keyes	5183
Miss-St. Louis	5216
Spergen	5376
Warsaw	5474
Harrison	5514
Osage	5529
RTD	5560
LTD	5562