KING SURVEYORS 650 E. GARDEN DR. WINDSOR, CO 80550

# SITE SKETCH

## SWD #C3A

SECTION: 32
TOWNSHIP: 4N
RANGE: 65W

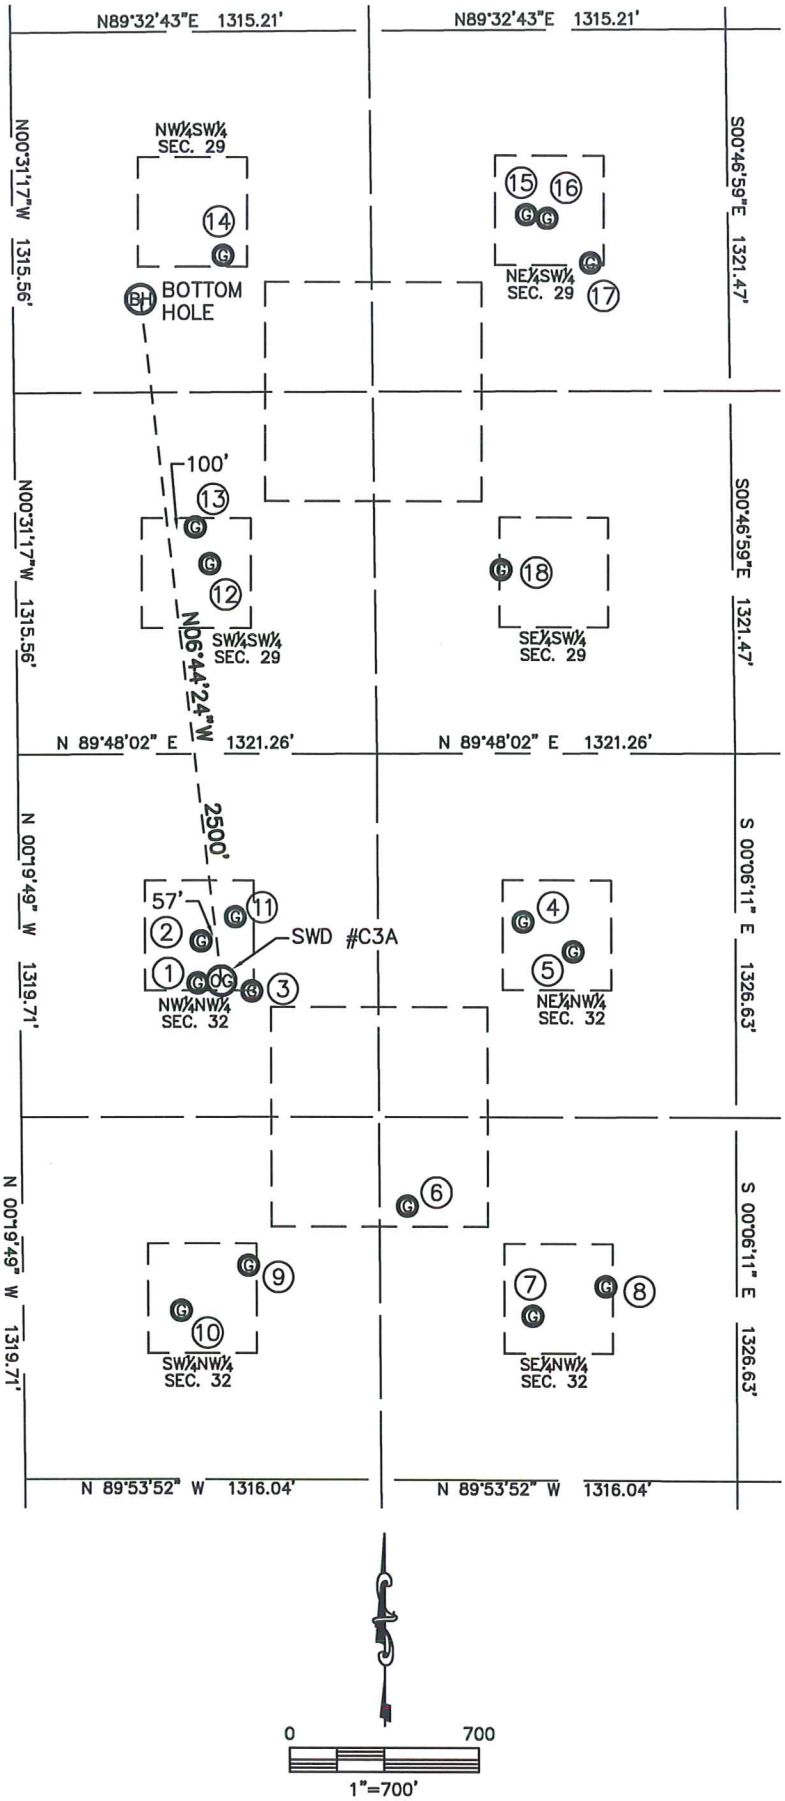


1
GERALDINE 32-1
NW1/4NW1/4
834' FNL
652' FWL
LAT-40.27388°N
LONG-104.69429°W
PDOP: 3.2
ELEV: 4903'

2
MUSICK-MCCLINTOCK 3
NW1/4NW1/4
681' FNL
665' FWL
LAT-40.27430°N
LONG-104.69423°W
PDOP: 1.9
ELEV: 4899'

3
HAMBERGT G 32-4X
NW1/4NW1/4
863' FNL
851' FWL
LAT-40.27380°N
LONG-104.69357°W
PDOP: 2.0
ELEV: 4900'

4
MUSICK-MCCLINTOCK 5
NE1/4NW1/4
613' FNL
1855' FWL
LAT-40.27447°N
LONG-104.68997°W
PDOP: 1.4
ELEV: 4905'

5
HAMBERGT R G 32-3
NE1/4NW1/4
722' FNL
2039' FWL
LAT-40.27417°N
LONG-104.68931°W
PDOP: 2.0
ELEV: 4910'

6
MUSICK 1-32
SE1/4NW1/4
1648' FNL
1420' FWL
LAT-40.27164°N
LONG-104.69154°W
PDOP: 1.4
ELEV: 4932'

7
HAMBERGT R G 32-6
SE1/4NW1/4
2050' FNL
1880' FWL
LAT-40.27053°N
LONG-104.68990°W
PDOP: 2.5
ELEV: 4939'

8
MUSICK-MCCLINTOCK 2
SE1/4NW1/4
1942' FNL
2151' FWL
LAT-40.27082°N
LONG-104.68892°W
PDOP: 1.9
ELEV: 4921'

9
MUSICK-MCCLINTOCK 6
SW1/4NW1/4
1863' FNL
831' FWL
LAT-40.27106°N
LONG-104.69365°W
PDOP: 1.6
ELEV: 4904'

10
HAMBERGT R G 32-5
SW1/4NW1/4
2026' FNL
581' FWL
LAT-40.27061°N
LONG-104.69455°W
PDOP: 1.6
ELEV: 4901'

11
HAMBERGT R G 32-4
(APPROXIMATE LOCATION ONLY-NO VISIBLE SIGNS OF WELL-ONLY STRONG METAL DETECTOR READING WHICH MATCHES CLOSELY TO LOCATION ON WELL LOCATION PLAT)
NW1/4NW1/4
593' FNL
793' FWL
LAT-40.27454°N
LONG-104.69377°W
PDOP: 1.2
ELEV: 4893'

12
UPRR 21 PANAM A 1
SW1/4SW1/4
692' FSL
709' FWL
LAT-40.27807°N
LONG-104.69407°W
PDOP: 2.7
ELEV: 4866'

13
HSR-MUNDS 13-29
SW1/4SW1/4
826' FSL
657' FWL
LAT-40.27844°N
LONG-104.69425°W
PDOP: 2.0
ELEV: 4863'

14
HSR-FROELICH 12-29
NW1/4SW1/4
1816' FSL
768' FWL
LAT-40.28116°N
LONG-104.69386°W
PDOP: 2.3
ELEV: 4851'

15
SPAYD 22-29
NE1/4SW1/4
1964' FSL
1890' FWL
LAT-40.28154°N
LONG-104.68984°W
PDOP: 3.4
ELEV: 4865'

16
UPRR 21 PANAM D 1
NE1/4SW1/4
1951' FSL
1966' FWL
LAT-40.28151°N
LONG-104.68956°W
PDOP: 2.7
ELEV: 4868'

17
HSR-CARTER 11-29
NE1/4SW1/4
1788' FSL
2125' FWL
LAT-40.28106°N
LONG-104.68899°W
PDOP: 2.8
ELEV: 4880'

18
HSR-DICKERSON 14-29A
SE1/4SW1/4
669' FSL
1785' FWL
LAT-40.27799°N
LONG-104.69021°W
PDOP: 2.9
ELEV: 4884'

PROJECT#: 2010104