


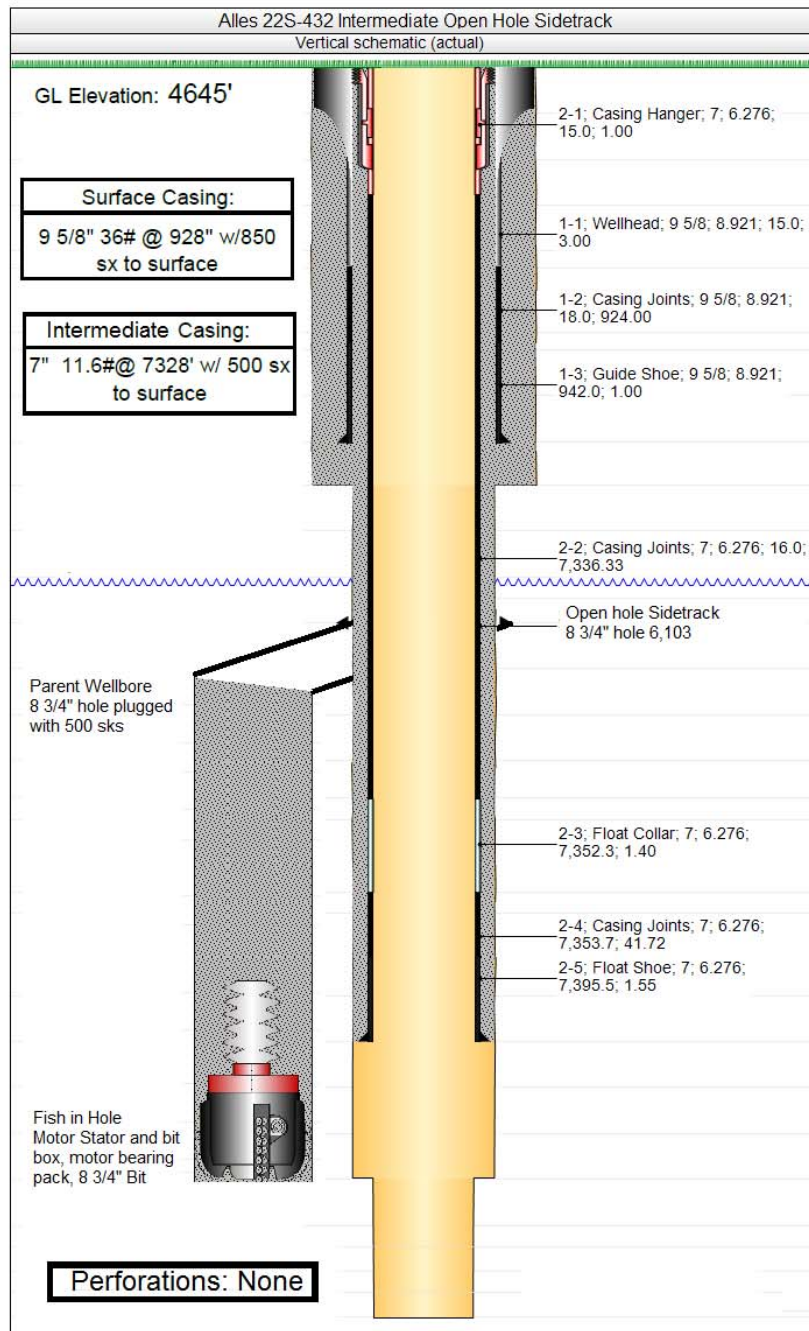

PDC Energy
 Alles #22S-432
 NESE 22 5N 65W 6 PM
 Weld County, CO
 Current Wellbore - NOT TO SCALE!!!
 3/26/2014
 API#: 05-123-37799



NOTES

Alles 22S-432: After completing the curve and POH with directional tools it was noticed bit and bottom of mud motor parted and stayed in the well. The decision to was made to plug back and side track instead of fishing due to hole angle and depth risk of not obtaining fish was too high.