

BILL BARRETT CORPORATION

RECLAMATION DIAGRAM FOR

RUH 6-62-11_14 NWNE PAD

#6-62-11-0560CH2, 0560BH2, 0659CH2 & 0659BH2

SECTION 11, T6N, R62W, 6th P.M.

NW 1/4 NE 1/4



FIGURE #4

SCALE: 1" = 100'

DATE: 02-20-14

DRAWN BY: J.W.

REV: 03-20-14

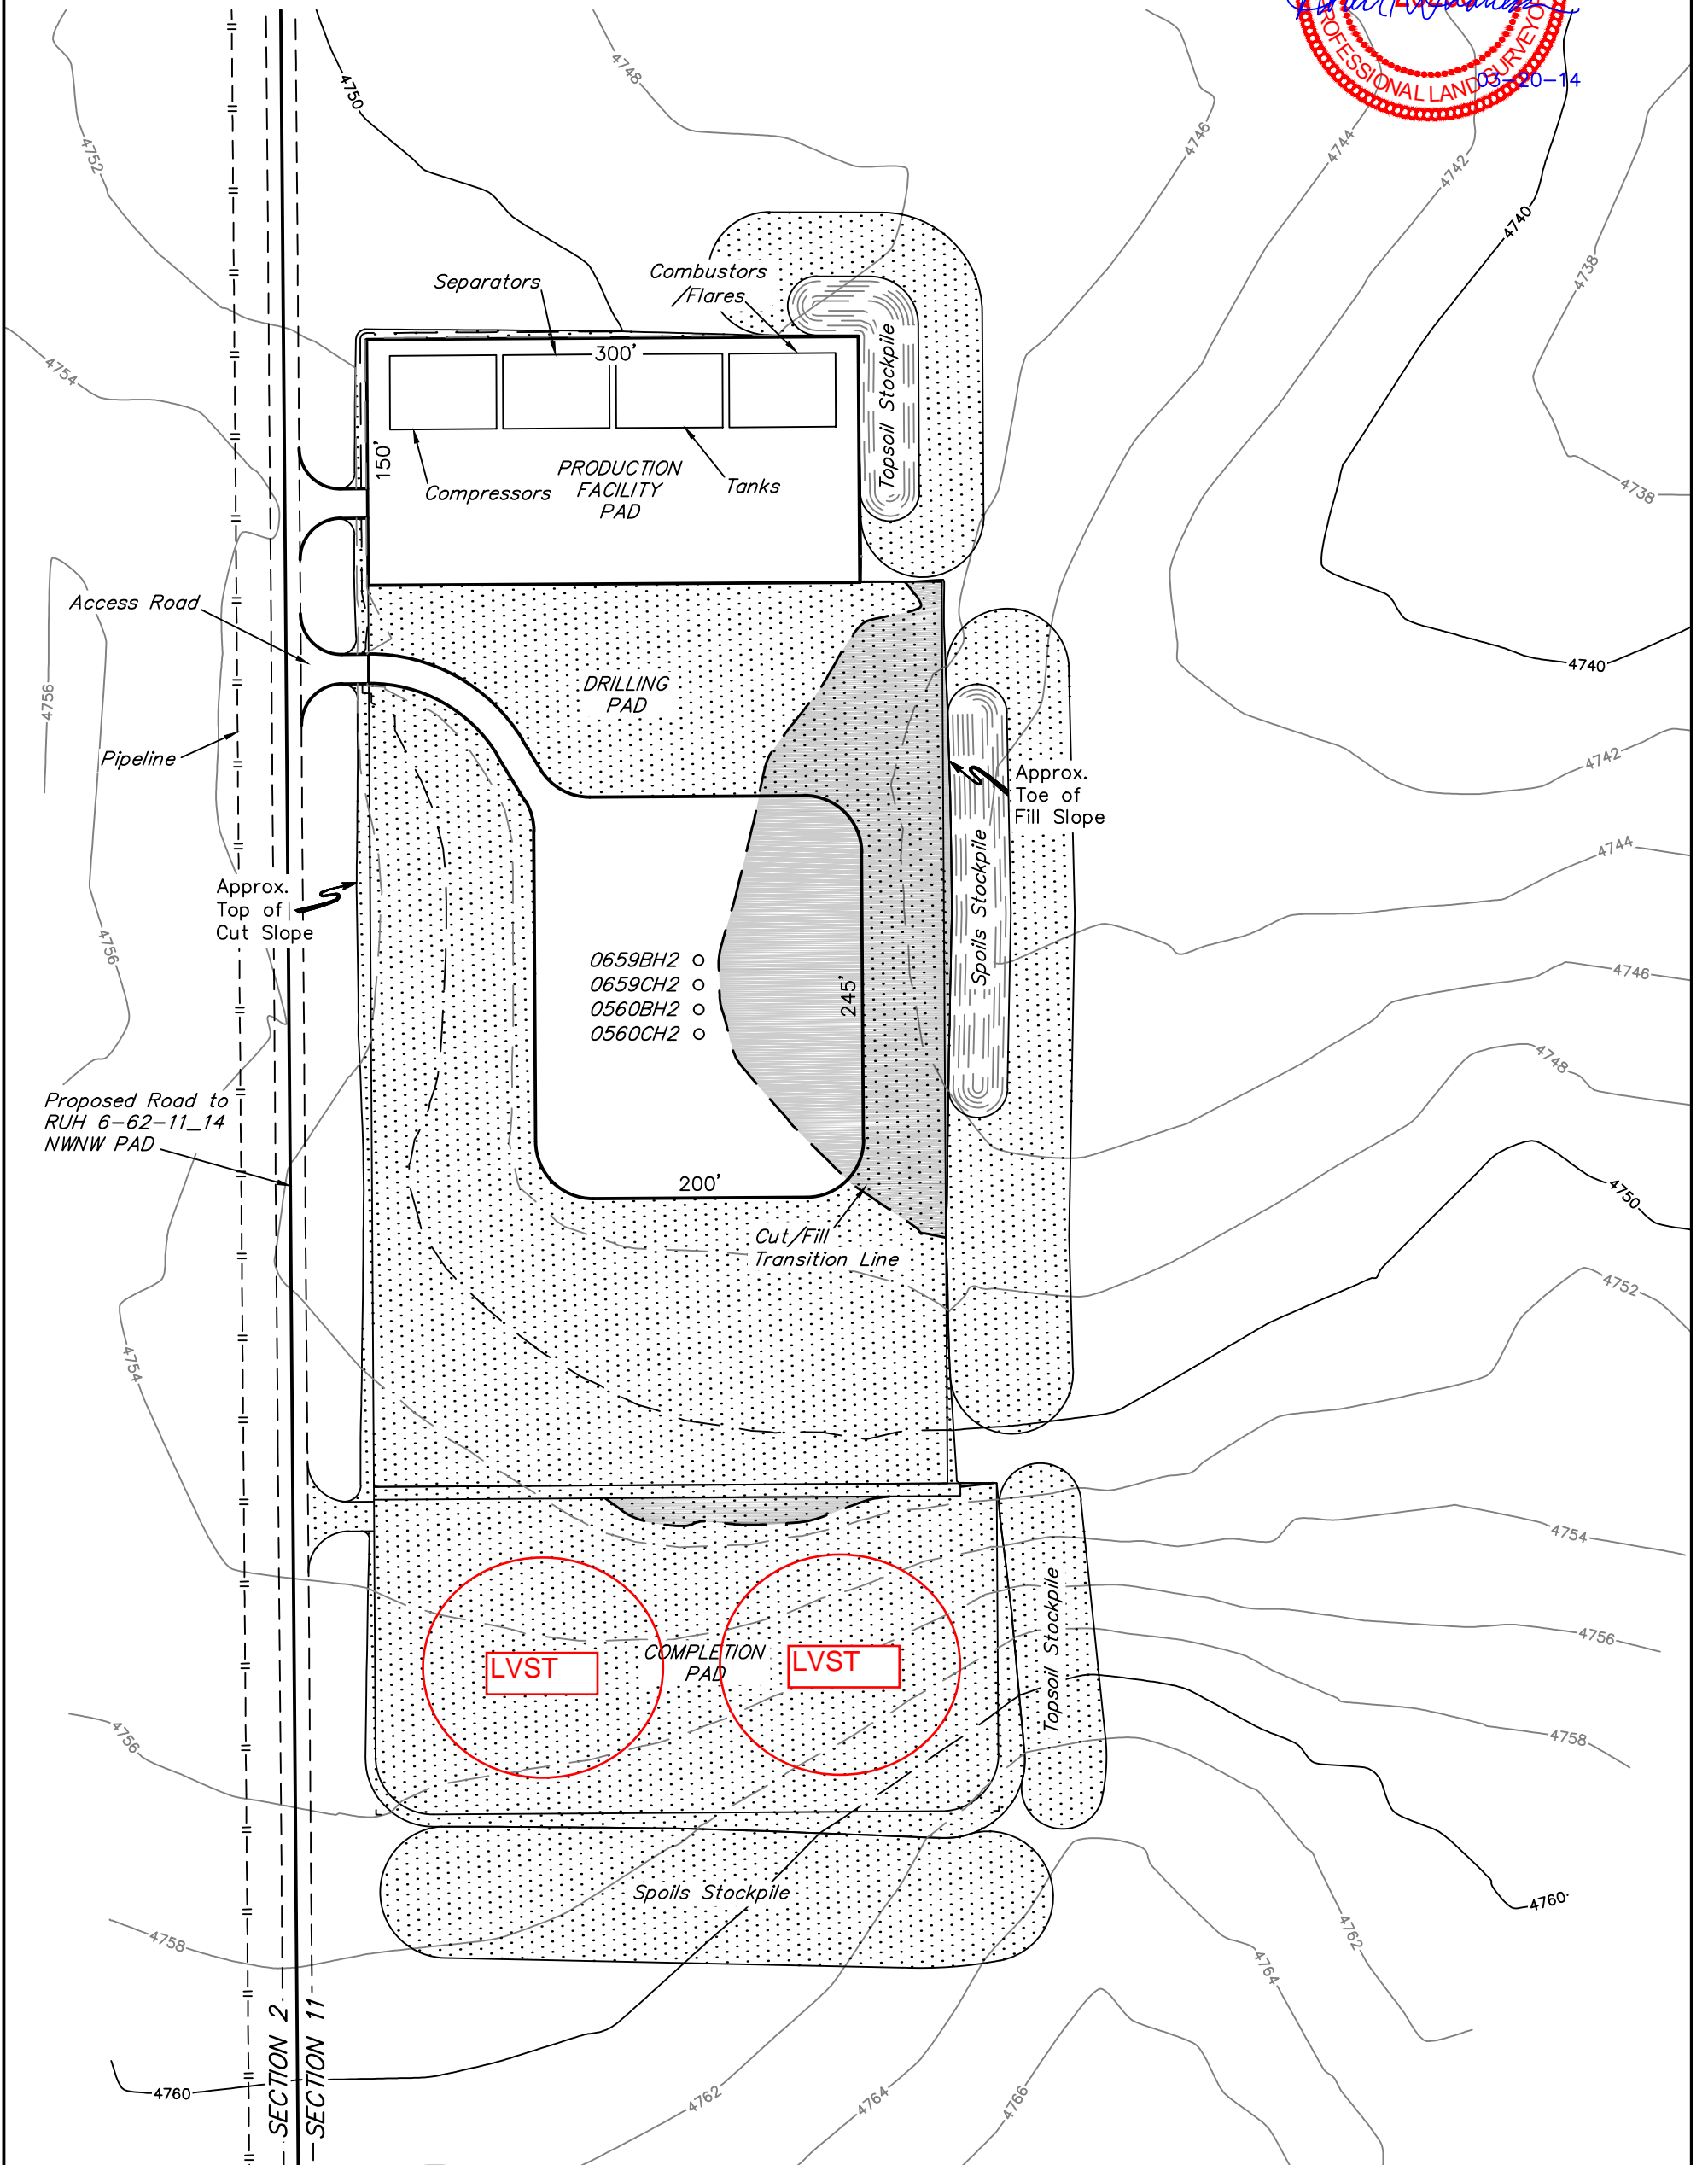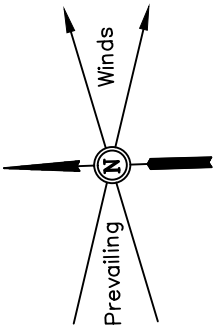

APPROXIMATE ACREAGE

RECLAIMED = ± 8.590 ACRES

UN-RECLAIMED = ± 2.671 ACRES

TOTAL = ± 11.261 ACRES

RECLAIMED AREA

UINTAH ENGINEERING & LAND SURVEYING
85 So. 200 East * Vernal, Utah 84078 * (435) 789-1017