


KERR-MCGEE OIL AND GAS ONSHORE LP

**BERRY 41-8
NE NE 8 3N 67W -- --
WELD,COLORADO
04/07/2014**

AREA: N2 ROUTE: N21 Spud: 01/24/1994 WINS No.: 76809 AFE/WO#: 2096285 API#: 0512317772

GL: 4828 KB: 4838 MTD: 7307 TVD: 7307 LOG MD: PBMD: 7251 PBTVD: 7251

Directions: WCR 17 & WCR 36, W 1/10, S 1/10 INTO

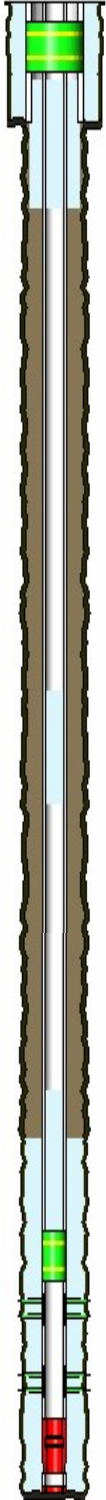

<u>HOLE SECTIONS</u>	<u>Size</u>	<u>Top</u>	<u>Btm</u>	<u>TD Date</u>			
SURFACE	12.25	10	410	01/24/1994			
PRODUCTION	7.88	410	7307	01/27/1994			
<u>TUBULARS</u>	<u>Tool Type</u>	<u>Joints</u>	<u>Size</u>	<u>Weight</u>	<u>Grade</u>	<u>Thread</u>	<u>Top D</u> <u>Bottom D</u>
SURFACE CASING	Casing	9	8.63	24			10 400
PRODUCTION CASING	Casing	191	3.50	7.7	WC-70		10 7251
	Casing Float Collar	1	3.50				7251 7253
	Casing	1	3.50	7.7	WC-70		7253 7287
	Casing Guide Shoe	1	3.50				7287 7288
BRIDGE PLUG	Cast Iron Bridge Plu		3.50				6880 6882
BRIDGE PLUG	Cast Iron Bridge Plu		8.63				100 102
<u>CEMENT JOBS</u>	<u>Stage</u>	<u>Sacks</u>	<u>Cement Jobs</u>		<u>Top D</u>	<u>Btm D</u>	<u>cbl</u>
SURFACE CASING	STAGE 1	285		NEAT	10	410	No
PRODUCTION CASING	STAGE 1	200		PREMIUM	6340	7307	Yes
PRODUCTION CASING	ABANDONMENT PLUC	30	LEAD	FRESH WATER	6049	6880	No
PRODUCTION CASING	ABANDONMENT PLUC	320	LEAD	FRESH WATER	3718	4390	No
SURFACE CASING	ABANDONMENT PLUC	370	LEAD	FRESH WATER	155	900	No
<u>PERFORATIONS</u>	<u>Formation</u>	<u>Zone</u>	<u>Top</u>	<u>Btm</u>	<u>Date</u>	<u>Reason</u>	<u>Comments</u>
	NIOBRARA		6942	6948	02/03/1994	PRODUCTION	
	CODELL		7151	7161	02/03/1994	PRODUCTION	

Comments: