

**WPX Energy Rocky Mountain LLC**

**FEDERAL RU 41-5**

**RULISON Field**


**SHL 211' FNL 2611' FWL (SE/4 NW/4) LOT 2 Section 5 T7S R93W 6th PM**

**BHL 352' FNL 686' FEL (NE/4 SE/4) LOT 1 Section 5 T7S R93W 6th PM**

**Garfield County Colorado**

**Formation Tops**

(Measured Depths)

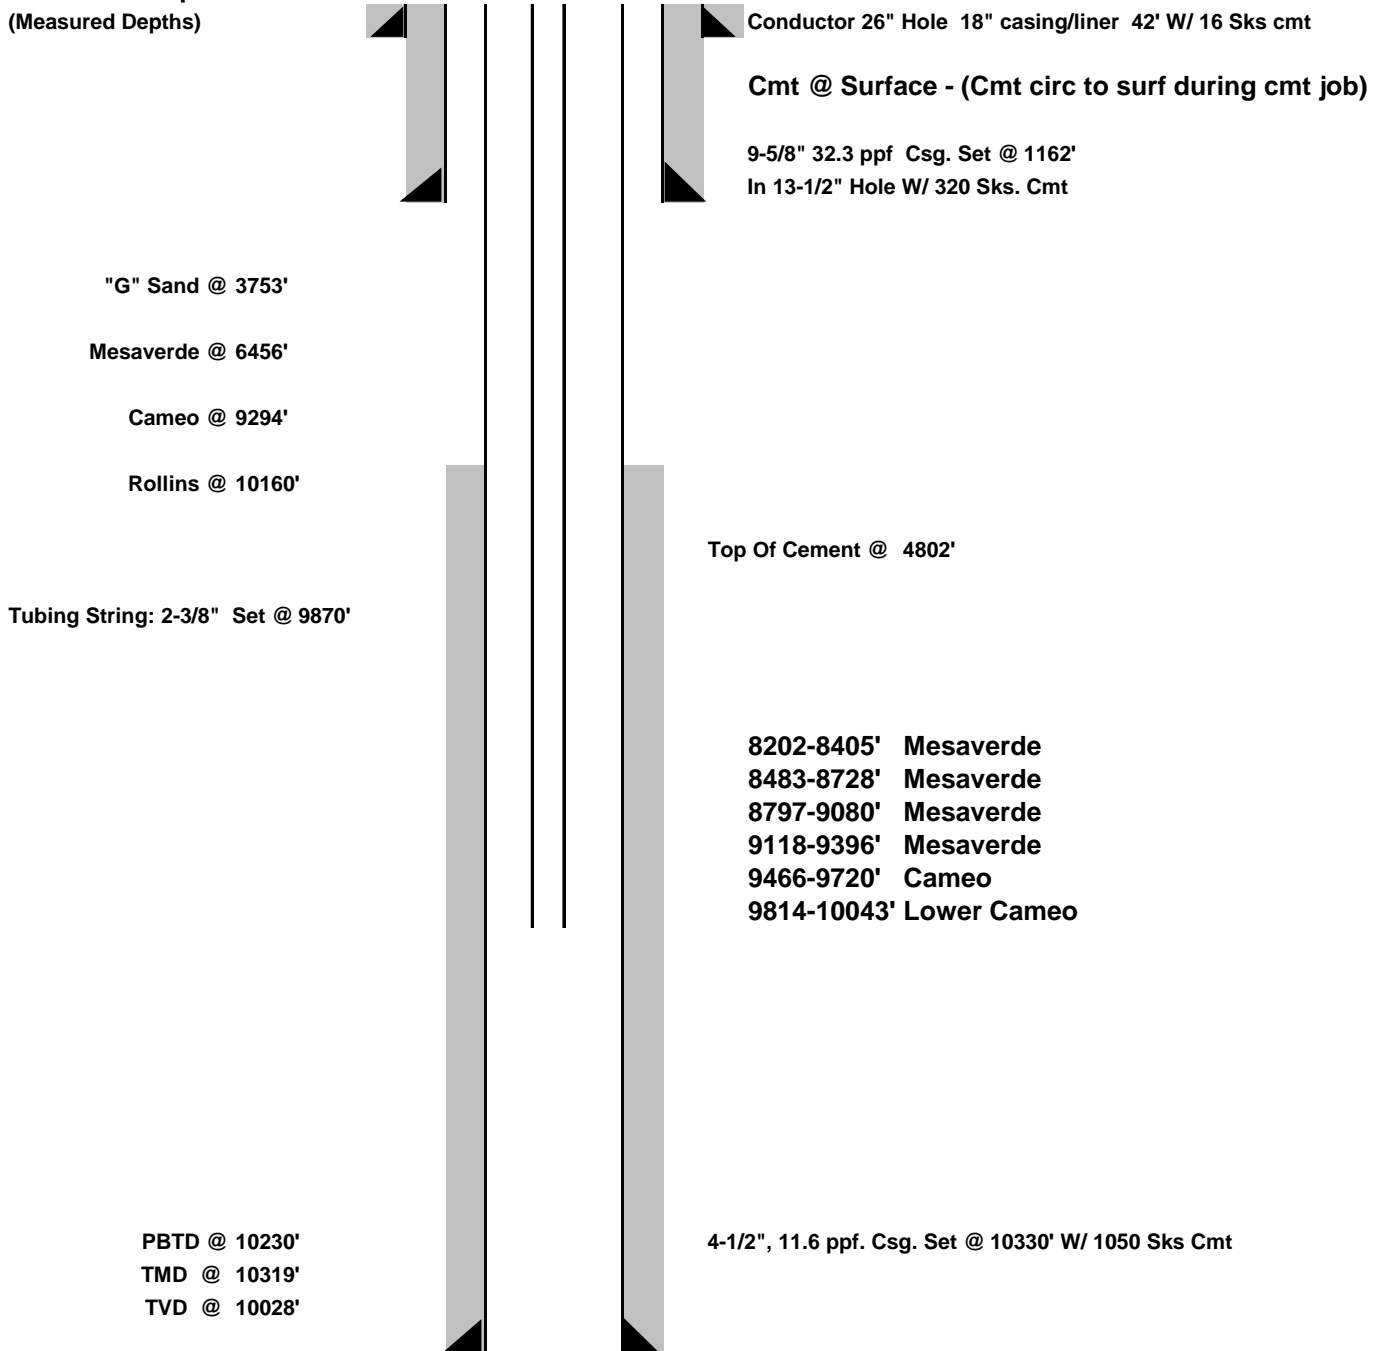

**DATE CREATED: 3/27/2014**

**NOTE: THIS IS NOT TO SCALE.**

**\*\*FINAL\*\***