

# WELLBORE DIAGRAM

**Synergy Resources Corp.**

**Phelps A-32CHZ**

SHL: 1796' FNL, 361' FEL

SENE Sec 32-T1N-R66W


Weld County, CO

05-123-37682

KB 5031  
GL 5019  
12

CIBP's set on 4-4-14 after High Bradenhead Pressure event and well SI.  
Awaiting Completion of associated pad wells before resuming work.

4/11/2014  
PAG

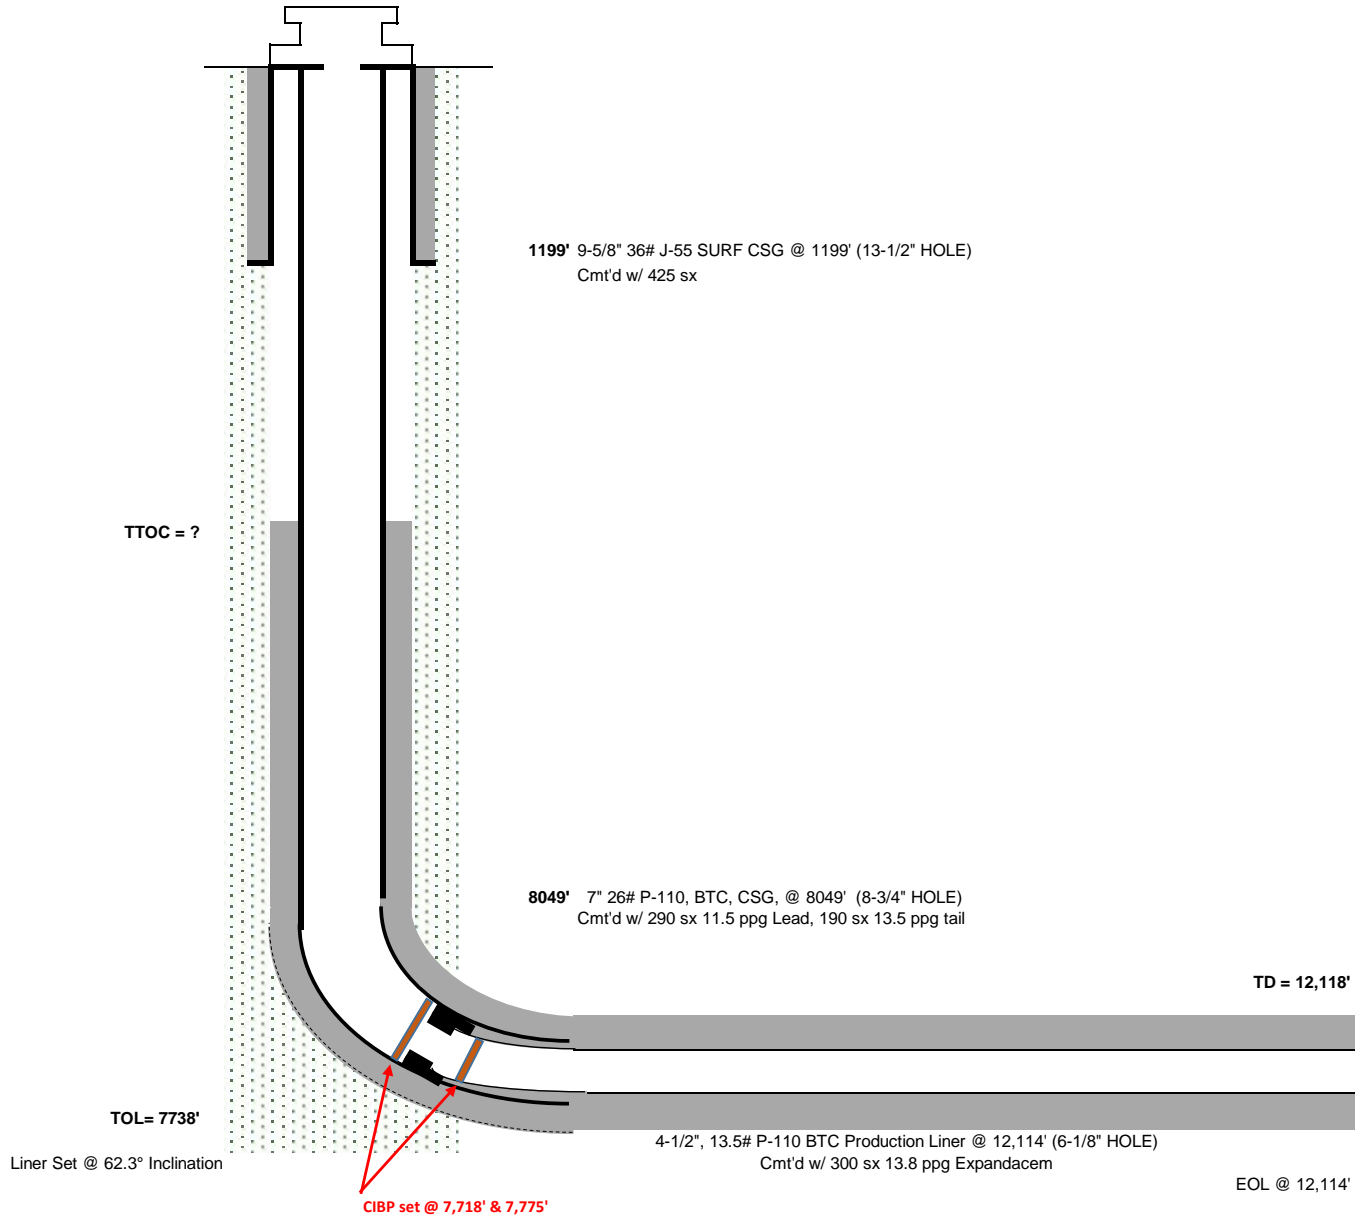

COMMENTS:

NOT TO SCALE