





Lat40°, Inc. 1635 Foxtrail Drive, Suite 325 Loveland, CO 970-776-3321

DRILLED & ABANDONED WELL EXHIBIT

THIS MAP DOES NOT REPRESENT A BOUNDARY SURVEY

SECTION: 16
TOWNSHIP: 5N
RANGE: 61W

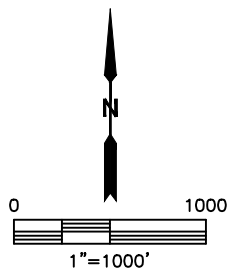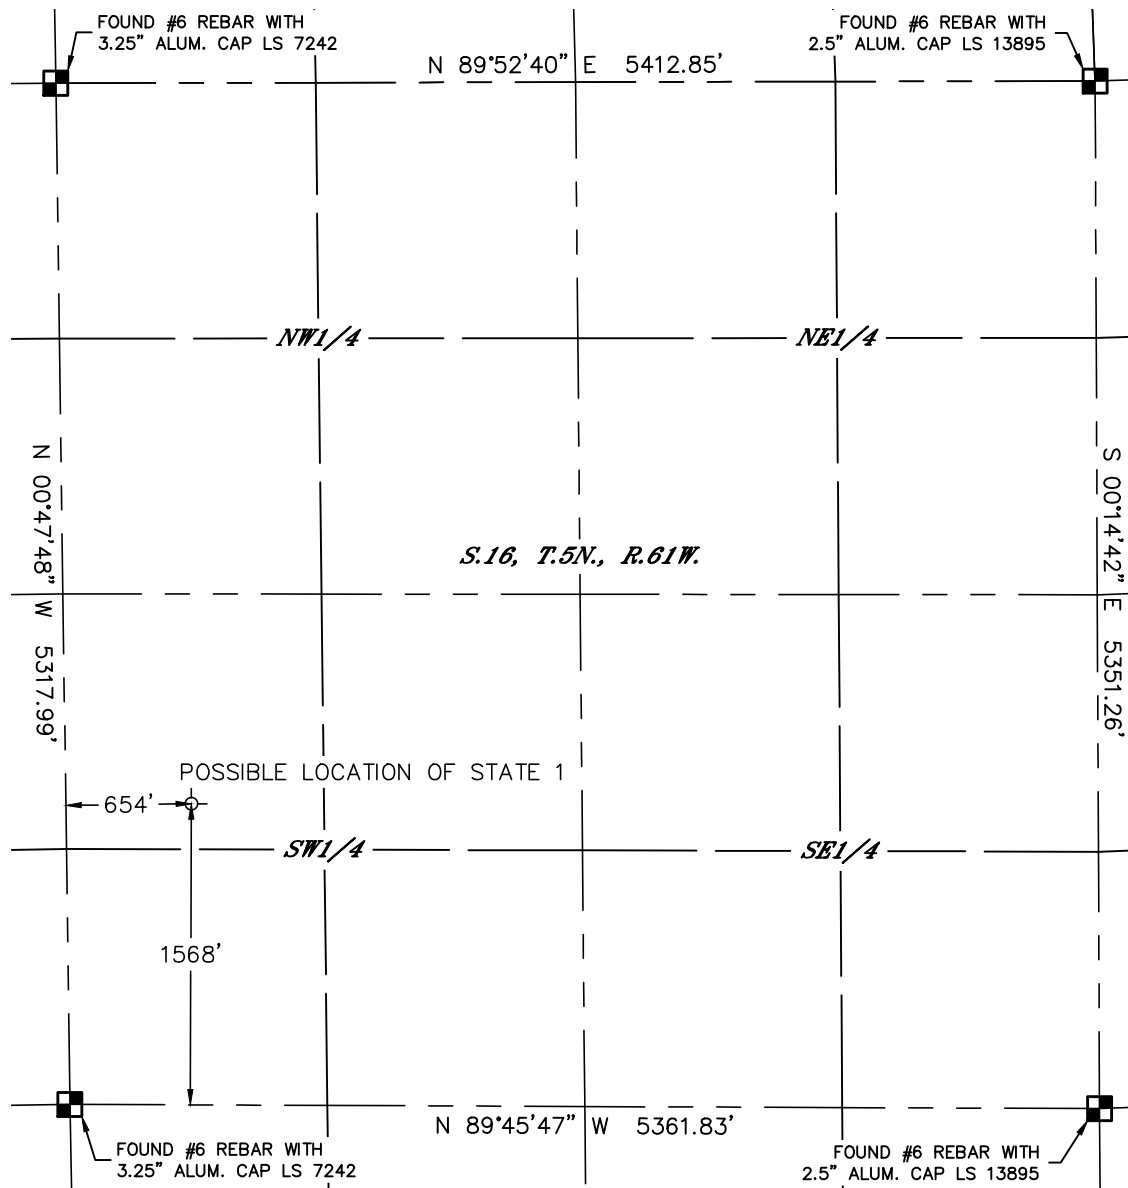

SURFACE LOCATION

LAT: 40.39813°N
LONG: 104.22132°W
PDOP: 2.1
ELEV: 4608'
1/4,1/4: NW1/4SW1/4

SURFACE DESCRIPTION

FOUND CONCRETE DEBRIS WITHIN A 4' AREA GIVING A STRONG METAL DETECTOR SIGNAL. SET ORANGE LATH.

LEGEND

- = ALIQUOT MONUMENT AS DESCRIBED
- = CALCULATED POSITION

DATE: 1/31/2014
PROJECT#: 2013173



Lat40°, Inc. 1635 Foxtrail Drive, Suite 325 Loveland, CO 970-776-3321

D&A WELL LOCATION PICTURES

STATE 1

SECTION: 16
TOWNSHIP: 5N
RANGE: 61W

DATE: 1/22/2014



VIEW NORTH



VIEW WEST



VIEW EAST



VIEW SOUTH

DATE: 1/31/2014
PROJECT#: 2013173