


Behring #1

660 FNL1980 FEL NWNE 12 5N 61W 6th PM
 Lat 40.42145 Long -104.15387 (from footages)
 Weld County, Colorado
 API #05-123-09426

Spud date 3/22/1978

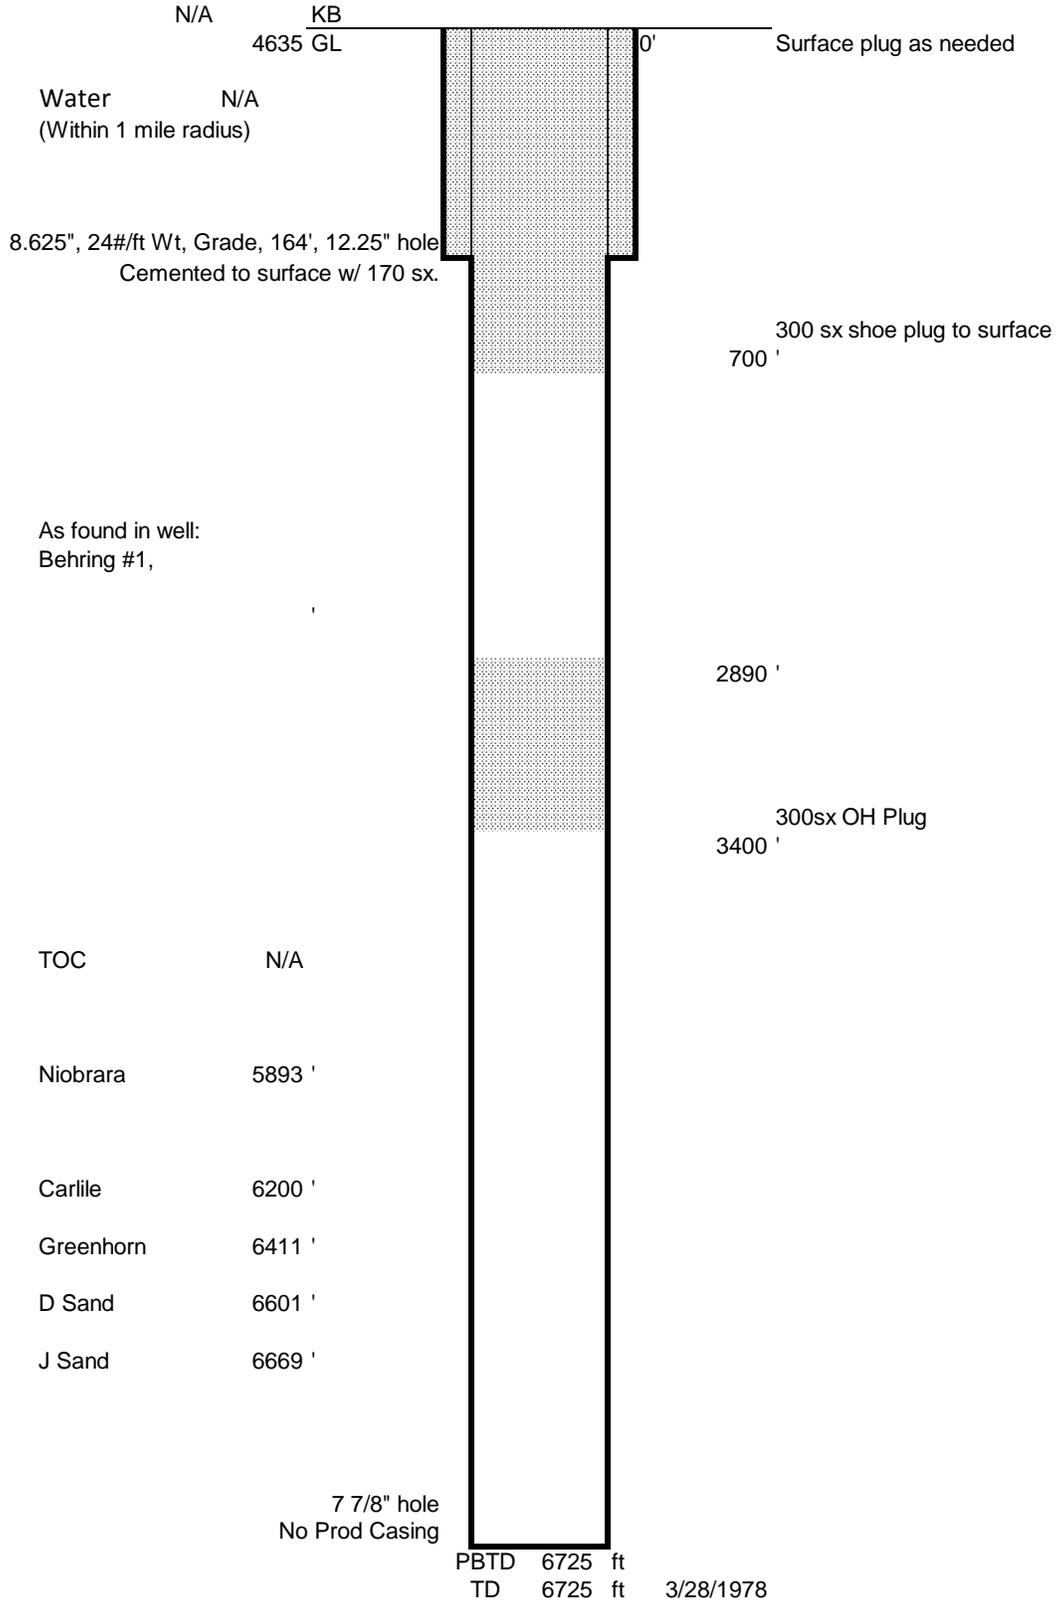

Updated 3/4/2014 jad