





Lat40°, Inc. 1635 Foxtrail Drive, Suite 325 Loveland, CO 970-776-3321

PLUGGED & ABANDONED WELL EXHIBIT

THIS MAP DOES NOT REPRESENT A BOUNDARY SURVEY

SECTION: 12
TOWNSHIP: 5N
RANGE: 61W

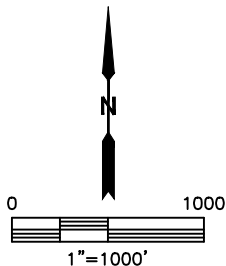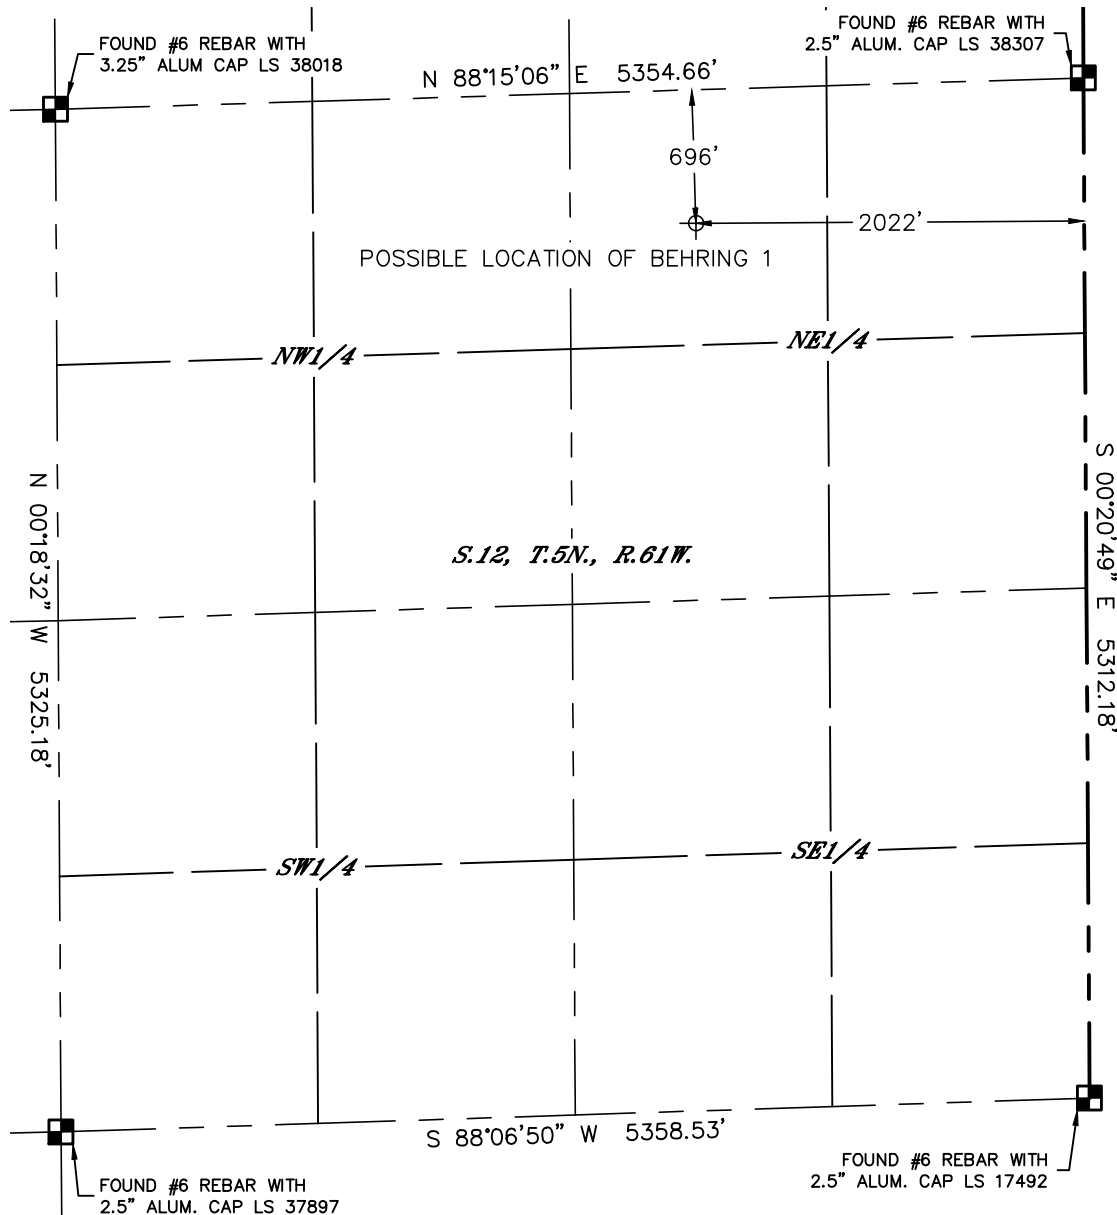

SURFACE LOCATION

LAT: 40.42145°N
LONG: 104.15387°W
PDOP: 2.1
ELEV: 4638'
1/4,1/4: NW1/4NE1/4

SURFACE DESCRIPTION

FOUND GROUT DEBRIS IN A 1' DEEP HOLE WITHIN A 4' AREA GIVING A STRONG METAL DETECTOR SIGNAL. AREA APPROXIMATELY 50' SOUTH OF A SOUTHEASTERLY RUNNING SWALE. SET ORANGE LATH.

LEGEND

- = ALIQUOT MONUMENT AS DESCRIBED
- = CALCULATED POSITION

DATE: 1/31/2014
PROJECT#: 2013173



Lat40°, Inc. 1635 Foxtrail Drive, Suite 325 Loveland, CO 970-776-3321

P&A WELL LOCATION PICTURES

BEHRING 1

SECTION: 20
TOWNSHIP: 5N
RANGE: 61W

DATE: 1/27/2014



VIEW NORTH



VIEW WEST



VIEW EAST



VIEW SOUTH

DATE: 1/31/2014
PROJECT#: 2013173