


BILL BARRETT CORPORATION
RECLAMATION DIAGRAM FOR
RUH 6-62-11_14 NENW PAD
#6-62-11-0362CH2, 0461CH2 & 0461BH2,
SECTION 11, T6N, R62W, 6th P.M.
NE 1/4 NW 1/4

FIGURE #4

SCALE: 1" = 100'
DATE: 01-27-14
DRAWN BY: J.W.
REV: 03-21-14

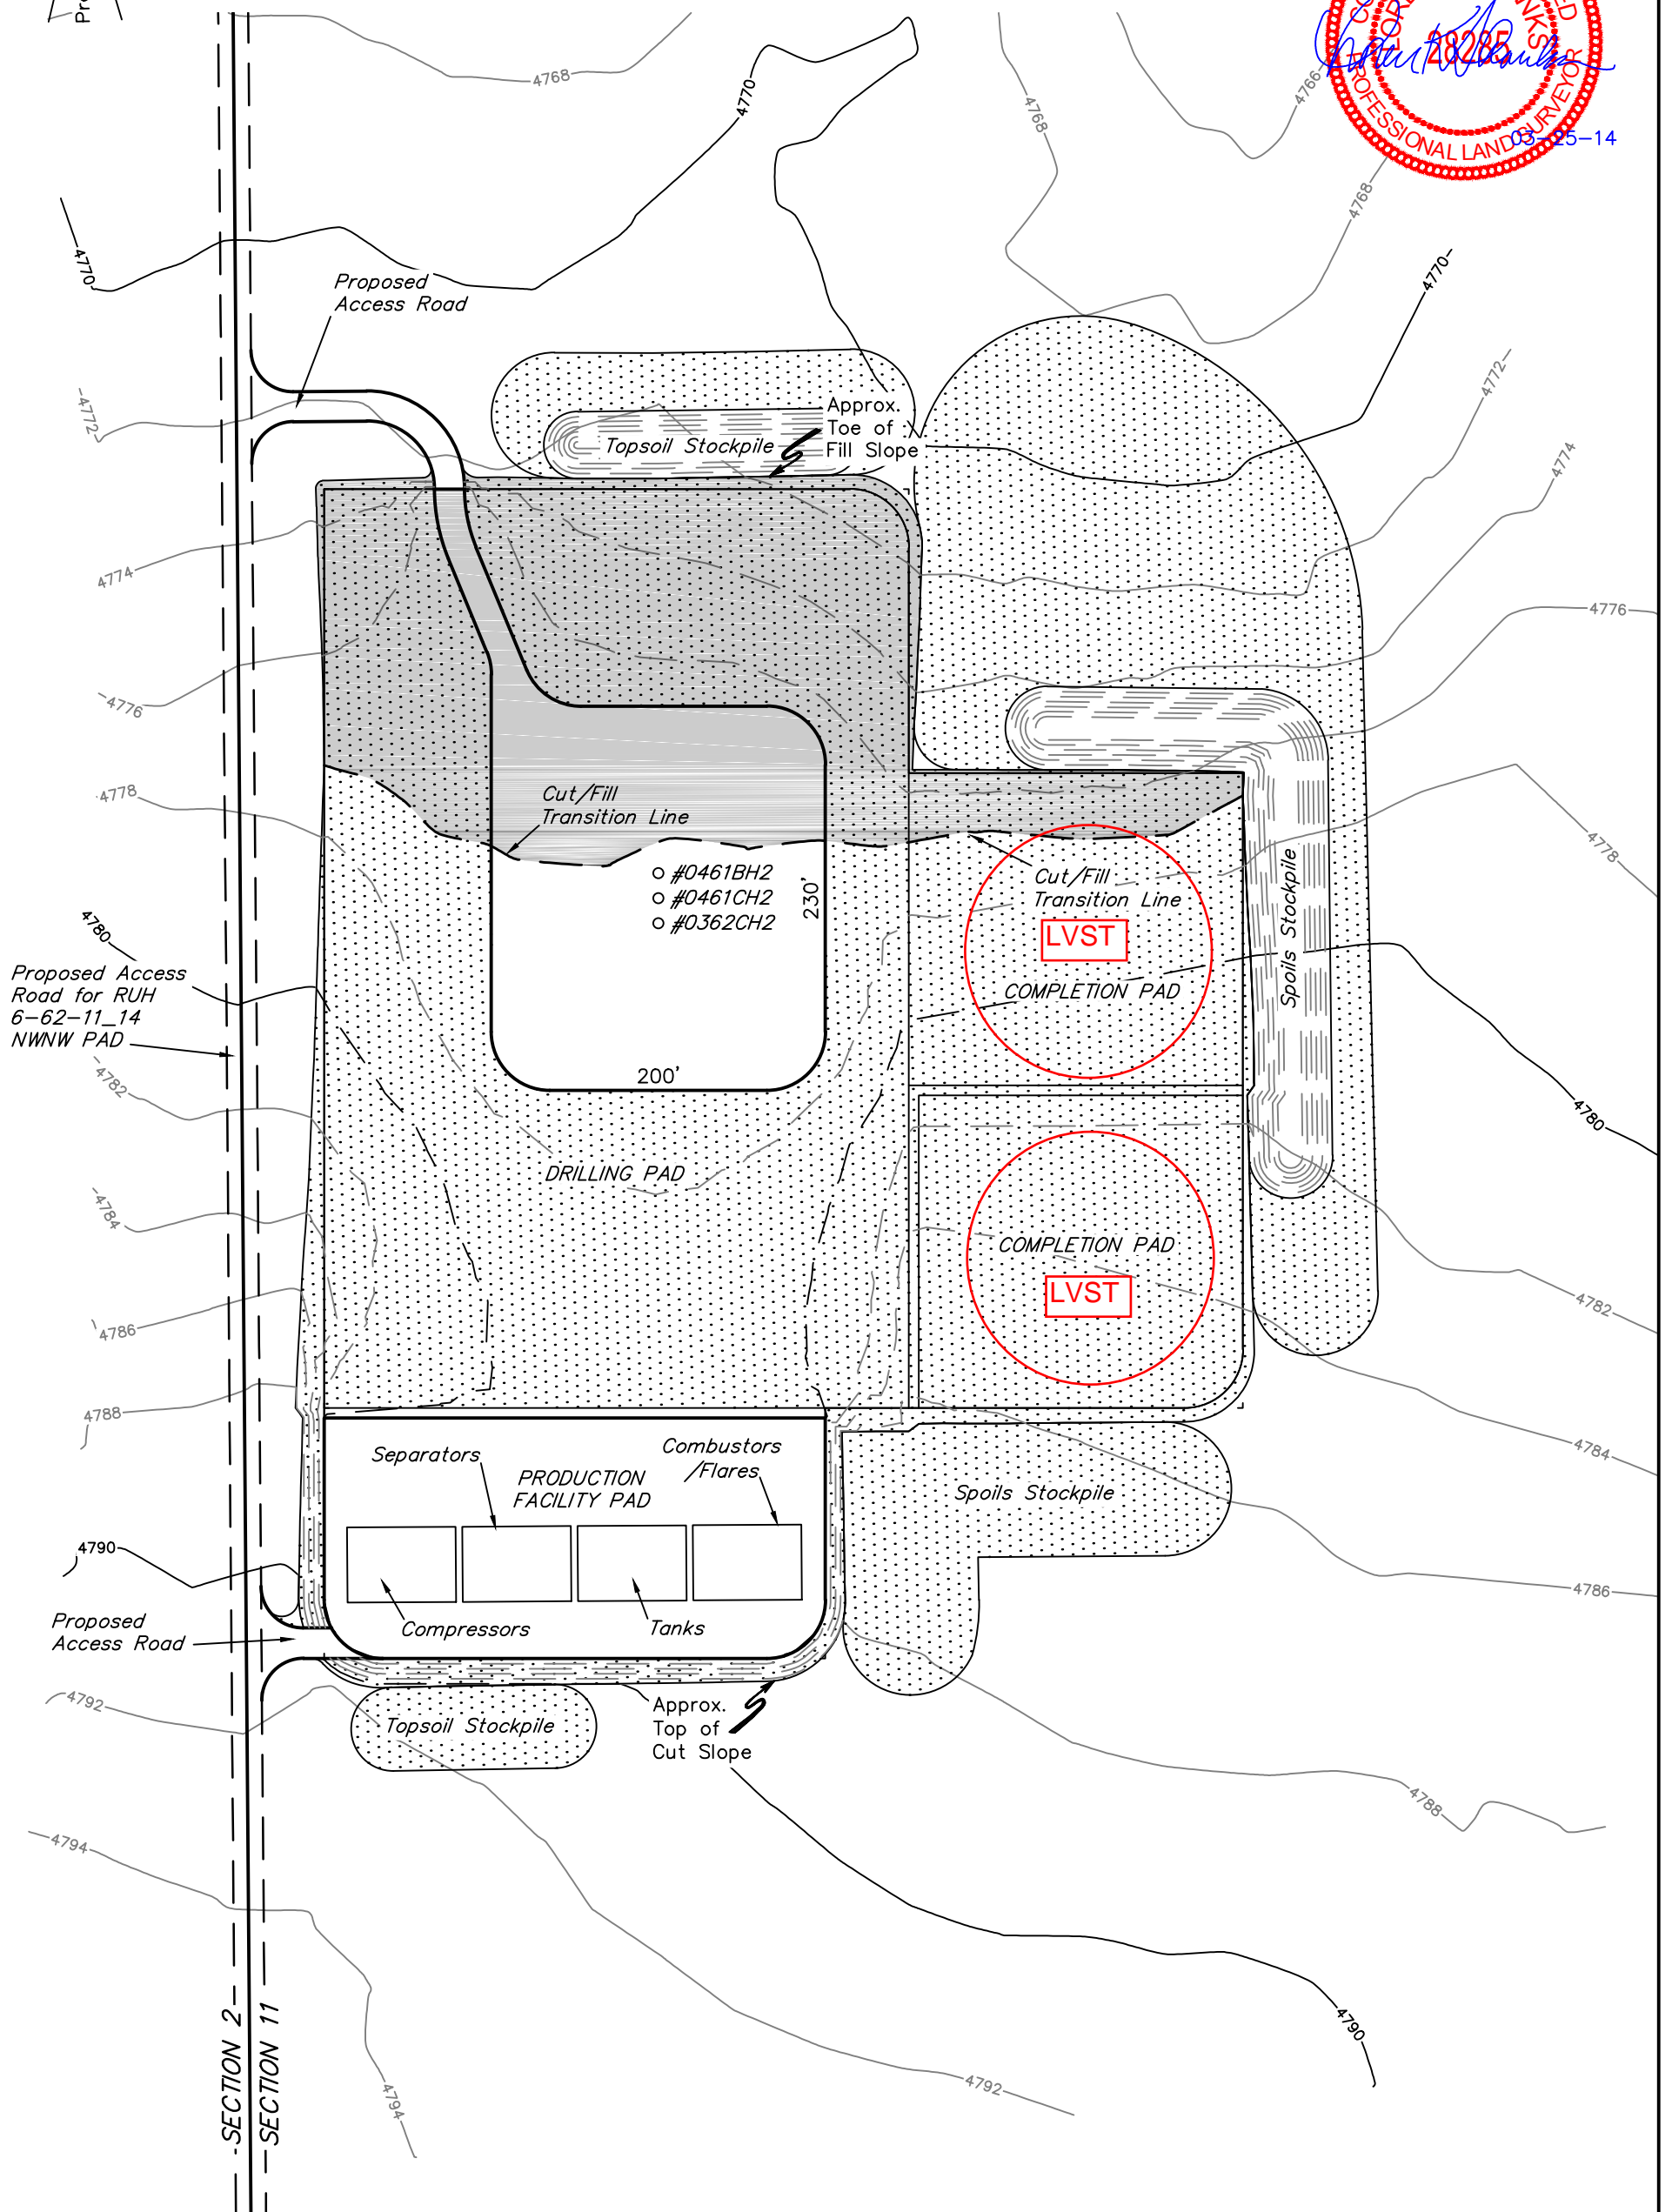

APPROXIMATE ACREAGE
UN-RECLAIMED = ± 3.007 ACRES

RECLAIMED AREA

UINTAH ENGINEERING & LAND SURVEYING
85 So. 200 East * Vernal, Utah 84078 * (435) 789-1017