

KERR-MCGEE OIL AND GAS ONSHORE LP

DUTCHER ROY UNIT 2

NE NW 24 2N 67W -- --

WELD,COLORADO

04/15/2014

AREA: W1

ROUTE: W15 Spud: 09/09/1980

WINS No.: 74374

AFE/WO#: 88484297

API#: 0512310067

GL: 4879

KB: 4889

MTD: 8022


TVD: 8022

LOG MD: 8022

PBMD: 7970

PBTVD: 7970

Directions: CR 20 & CR 23, S 5/10, E&N 5/10,E&S 2/10, NE 1/10, W INTO.

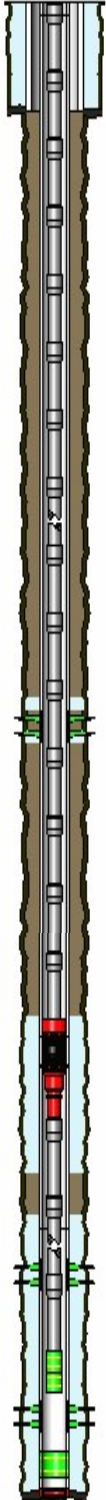

<u>HOLE SECTIONS</u>	<u>Size</u>	<u>Top</u>	<u>Btm</u>	<u>TD Date</u>				
SURFACE	12.25	10	685	09/09/1980				
PRODUCTION	7.88	685	8022	09/17/1980				
<u>TUBULARS</u>	<u>Tool Type</u>	<u>Joints</u>	<u>Size</u>	<u>Weight</u>	<u>Grade</u>	<u>Thread</u>	<u>Top D</u>	<u>Bottom D</u>
SURFACE CASING	Casing	16	8.63	24	K-55		10	679
PRODUCTION CASING	Casing	2	4.50	11.6	J-55		10	83
	Casing	181	4.50	10.5	J-55		83	7223
	Casing	18	4.50	11.6	J-55		7223	7978
		1	4.50				7978	7980
	Casing	1	4.50	11.6	J-55		7980	8021
	Casing Guide Shoe	1	4.50				8021	8022
PRODUCTION TUBING	Tubing	207	2.38	4.70	J-55		10	6522
	Packer	1	4.00				6522	6529
	Tubing	41	2.38	4.70	J-55		6529	7818
	XN Profile Nipple	1	2.38				7818	7819
	Notched Collar	1					7819	7819
<u>CEMENT JOBS</u>	<u>Stage</u>	<u>Sacks</u>	<u>Cement Jobs</u>		<u>Top D</u>	<u>Btm D</u>	<u>cbl</u>	
SURFACE CASING	STAGE 1	400	REGULAR		10	685	No	
PRODUCTION CASING	SQUEEZE 1				4660	4804	Yes	
	SQUEEZE 3	100	G		4324	4410	Yes	
	STAGE 1				7128	8022	Yes	
	SQUEEZE 2				4506	4538	Yes	
--None--	SQUEEZE JOB				6510	6880	No	
<u>PERFORATIONS</u>	<u>Formation</u>	<u>Zone</u>	<u>Top</u>	<u>Btm</u>	<u>Date</u>	<u>Reason</u>	<u>Comments</u>	
	SUSSEX		4405	4800	02/27/1995	PRODUCTION		
	CODELL		7412	7433	03/08/1995	PRODUCTION		
	J SAND		7870	7900	11/11/1980	PRODUCTION		

Comments: