


Well Completion Diagram

| | | | |
|-------------------------------|-----------------------|------------|---------|
| API Well No: 05-009-06673-00- | | | |
| Owner: | CHOLLA PRODUCTION LLC | Well Name: | Baldwin |
| County: | BACA | Field: | WILDCAT |
| Coordinates: X | | Sec: | 18 |
| | | Twp: | 32S |
| | | Rng: | 44W |

Note: Changes to the drawing do not effect the database

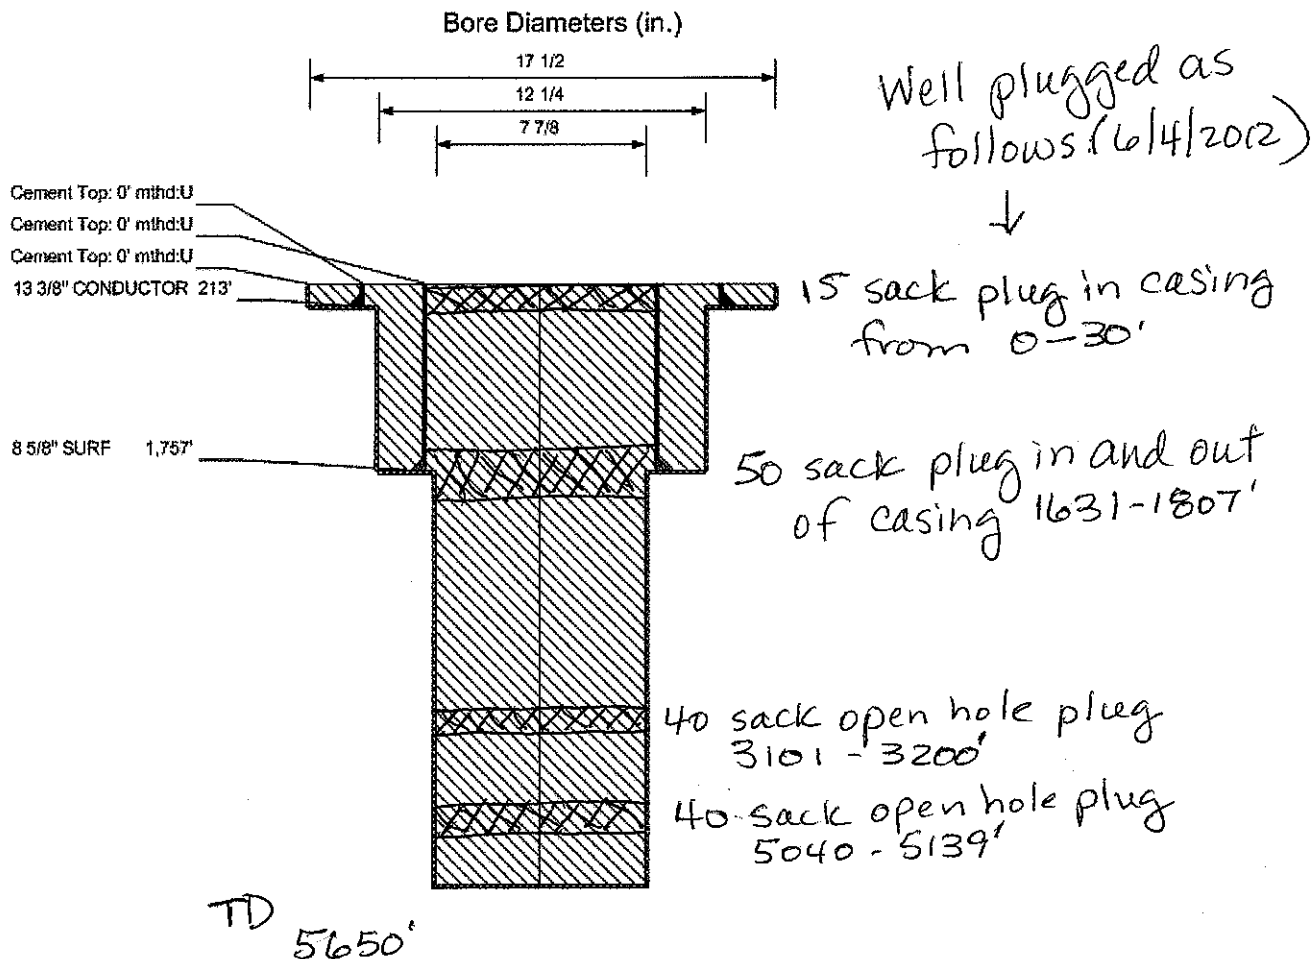

