


SPUD: 11/11/55  
COMP: 11/22/55  
ABDN: 9/18/67  
COGCC: PA

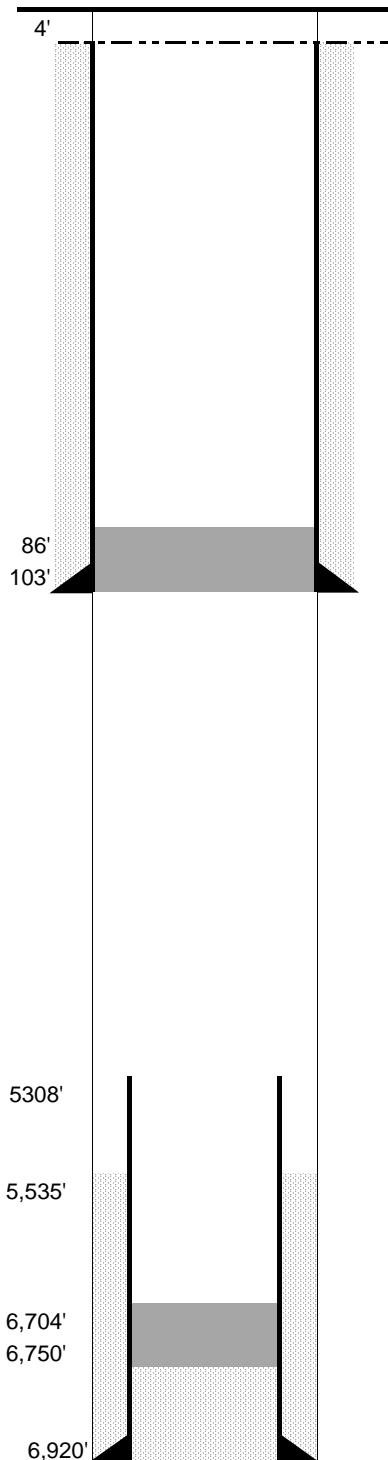

## SURFACE CASING

DEPTH: 103' SIZE: 8.625" GRADE: \_\_\_\_\_ WT (#/ft): 24.0  
CEMENT: 125 sx  
COMMENTS: \_\_\_\_\_

## PRODUCTION CASING

DEPTH: 6.920' SIZE: 5.5" GRADE: J-55 WT (#/ft): 17#  
CEMENT: 200 sx TOC: 5,535' est  
COMMENTS:

|        |                   |   |                   |              |                   |
|--------|-------------------|---|-------------------|--------------|-------------------|
| PERFS: | <u>6,790'</u>     | - | <u>6,800'</u>     | PROD ZONE 1: | <u>D Sand</u>     |
| PERFS: | <u>          </u> | - | <u>          </u> | ZONE 2:      | <u>          </u> |
| PERFS: | <u>          </u> | - | <u>          </u> | ZONE 3:      | <u>          </u> |

## PLUGGING REPORT

ZONE 1 CIBP: \_\_\_\_\_ CMT: \_\_\_\_\_ OTHER: \_\_\_\_\_  
 2 CIBP: \_\_\_\_\_ CMT: \_\_\_\_\_ OTHER: \_\_\_\_\_  
 3 CIBP: \_\_\_\_\_ CMT: \_\_\_\_\_ OTHER: \_\_\_\_\_

|            |               |       |               |  |
|------------|---------------|-------|---------------|--|
| RECOVERED: | <u>5,308'</u> | SIZE: | <u>5.5"</u>   |  |
| CMT 1:     | <u>6,750'</u> | -     | <u>6,704'</u> | COMMENT: <u>5 sx cement on pea gravel</u>  |
| CMT 2:     | <u>103'</u>   | -     | <u>86'</u>    | COMMENT: <u>5 sx cement at casing shoe</u> |
| CMT 3:     |               | -     |               | COMMENT:                                   |

OTHER: No record of surface plug on cutting off casing

**FORMATIONS:**

|            |        |
|------------|--------|
| FOX HILLS: |        |
| NIOBRARA:  | 6,047' |
| CODELL:    |        |
| D SAND:    | 6,787' |
| J SAND:    | 6,875' |