


WELL NAME: H.H. Duell B-2
OPERATOR: J & L Oil Corporation
COMP ZONE: D Sand
LOCATION: 8N 60W S25 SE SW

COUNTY: Weld
STATE: Colorado
API : 05-123-15471
GL/KB: 4897' /

SPUD: 11/11/55
COMP: 11/22/55
ABDN: 9/18/67
COGCC: PA

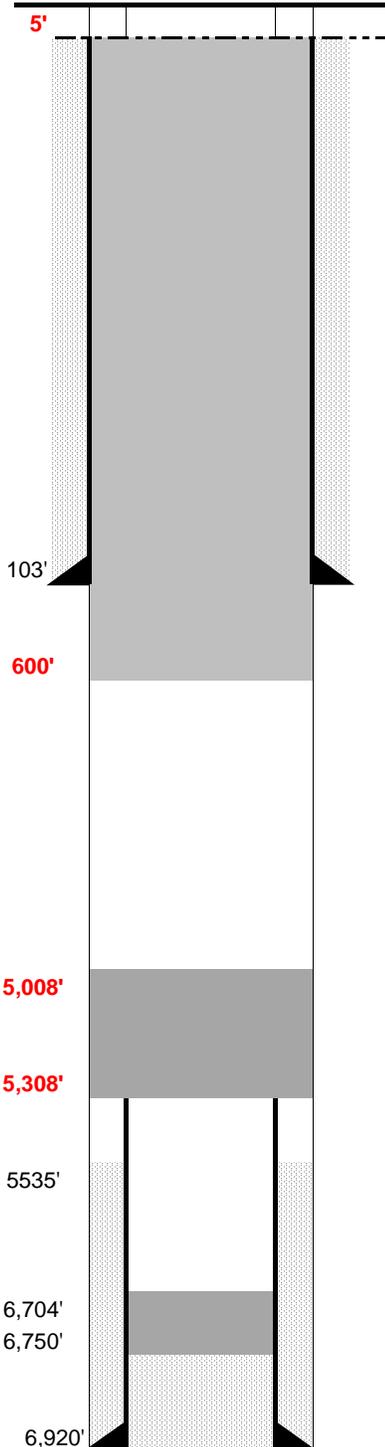

SURFACE CASING

DEPTH: 103' SIZE: 8.625" GRADE: _____ WT (#/ft): 24.0
 CEMENT: 125 sx
 COMMENTS: _____

PRODUCTION CASING

DEPTH: 6,920' SIZE: 5.5" GRADE: J-55 WT (#/ft): 17#
 CEMENT: 200 sx TOC: 5,535' est
 COMMENTS: _____

PERFS: 6,790' - 6,800' PROD ZONE 1: D Sand
 PERFS: _____ - _____ ZONE 2: _____
 PERFS: _____ - _____ ZONE 3: _____

PREVIOUS PLUGS

ZONE 1 CIBP: _____ CMT: _____ OTHER: _____
 2 CIBP: _____ CMT: _____ OTHER: _____
 3 CIBP: _____ CMT: _____ OTHER: _____

RECOVERED: 5,308' SIZE: 5.5"
 CMT 1: 6,750' - 6,704' COMMENT: 5 sx cement on pea gravel
 CMT 2: 103' - 86' COMMENT: 5 sx cement at casing shoe
 CMT 3: _____ - _____ COMMENT: _____

PROPOSED Plug #1: 100 sx cement from 5,308' to 5,008' (on top of csg stub)
Plug #2: Cement plug from 600' to surface (Isolate FW zones)

FORMATIONS:

NIOBRARA: 6,047'
 CODELL _____
 CARLILE _____
 GREENHORN _____
 BENTONITE _____
 D SAND 6,787'
 J SAND 6,875'