






WELL LOCATION CERTIFICATE

SECTION: 9
TOWNSHIP: 4N
RANGE: 66W

THIS MAP DOES NOT REPRESENT A BOUNDARY SURVEY

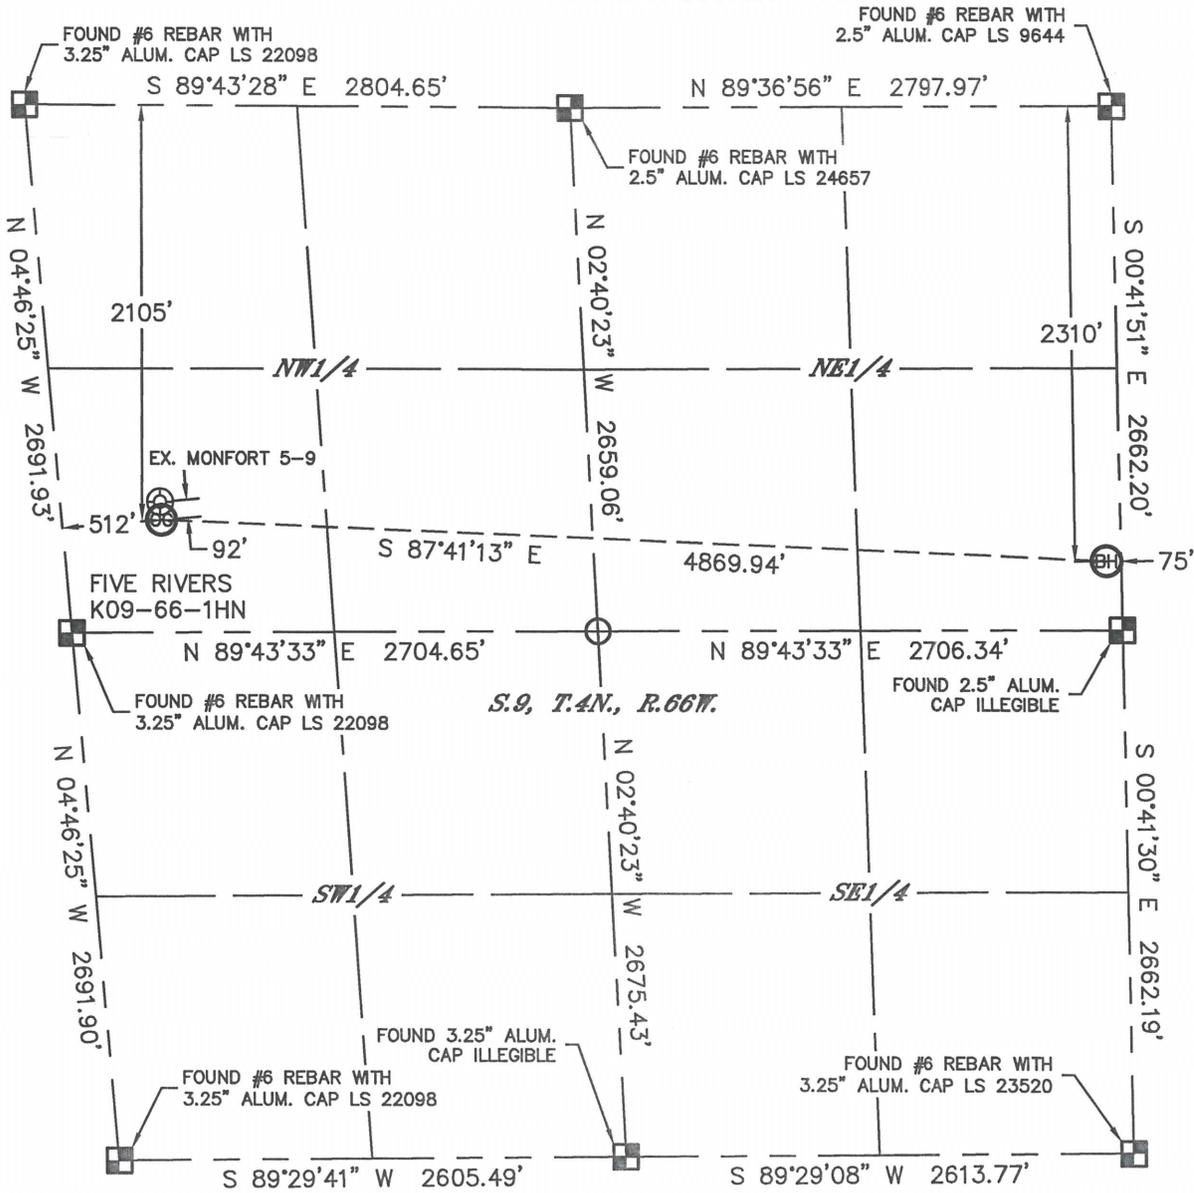

S.9, T.4N., R.66W.

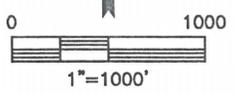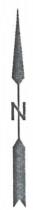

In accordance with a request from Brian DeRose with Noble Energy Inc. Lat40, Inc. has determined the surface location of the FIVE RIVERS K09-66-1HN to be 2105' from the NORTH line and 512' from the WEST line and the bottom hole to be 2310' from the NORTH line and 75' from the EAST line as measured at right angles from the section lines of Section 9, Township 4 North, Range 66 West of the Sixth Principal Meridian, County of Weld, State of Colorado.

I hereby state that this Well Location Certificate was prepared by me, or under my direct supervision, that the fieldwork was completed on 11/19/2013, for and on behalf of Noble Energy Inc. That this is not a Land Survey Plat or an Improvement Survey Plat, and that it is not to be relied upon for establishment of fence, building, or other future improvement lines.


- NOTE:
- 1) Bearings shown are Grid Bearings of the Colorado State Plane Coordinate System, North Zone, North American Datum 1983/2007. The lined dimensions as contained herein are based upon the "U.S. Survey Foot."
 - 2) Ground elevations are based on an observed GPS elevation (NAVD 1988 DATUM).
 - 3) IMPROVEMENTS: See LOCATION DRAWING for all visible improvements within 500' of disturbed area.
 - 4) SURFACE USE: RANGELAND
 - 5) INSTRUMENT OPERATOR: WYATT HALL
 - 6) NEAREST EXISTING WELL: MONFORT 5-9, 92'
- NEAREST CULTURAL ITEMS:
BUILDING: ±1307' SE
BUILDING UNIT: ±3360' NW
HIGH OCCUPANCY BUILDING UNIT: 1001'+
DESIGNATED OUTSIDE ACTIVITY AREA: 1001'+
PUBLIC ROAD: 3244' S (CR 46)
ABOVEGROUND UTILITY: 515' SE
RAILROAD: ±2948' NW
PROPERTY LINE: 512' W

SURFACE LOCATION
LAT: 40.32784°N
LONG: 104.79101°W
PDOP: 1.3
ELEV: 4699'
1/4,1/4: SW1/4NW1/4

BOTTOM HOLE
LAT: 40.32720°N
LONG: 104.77356°W

LEGEND

- = ALIQUOT MONUMENT AS DESCRIBED
- = CALCULATED POSITION

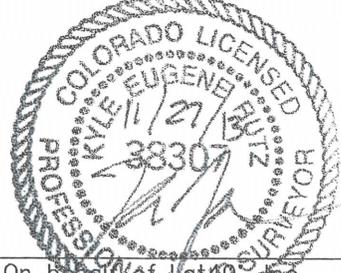

Kyle E. Rutz—On behalf of Lat40, Inc.
Colorado Licensed Professional Land Surveyor No. 38307
DATE: 11/27/2013
PROJECT#: 2013063




Lat40°, Inc. 1635 Foxtrail Drive, Suite 325 Loveland, CO 970-776-3321

SITE SKETCH


FIVE RIVERS K09-66-1HN

SECTION: 9
TOWNSHIP: 4N
RANGE: 66W

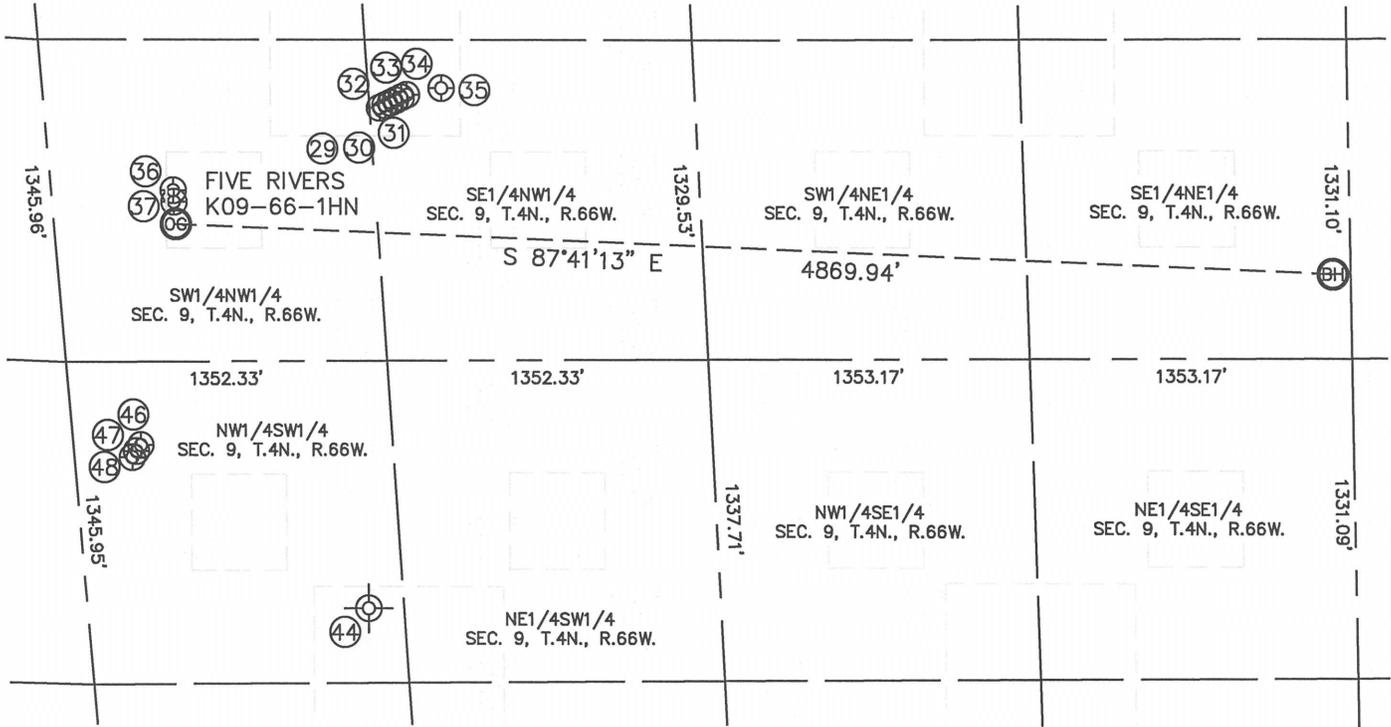

| WELL NO. | WELL NAME | SHL FOOTAGE | | | SHL LAT° | SHL LONG° | PDOP | ELEV (FT.) | 1/4/1/4 | |
|----------|-------------------------|-------------|-----|------|----------|-----------|------------|------------|---------|------|
| 29 | FIVE RIVERS USX K 9-19 | 1617 | FNL | 1409 | FWL | 40.32915 | -104.78791 | 1.8 | 4699 | SENW |
| 30 | FIVE RIVERS USX K 9-24D | 1607 | FNL | 1433 | FWL | 40.32918 | -104.78783 | 2.0 | 4699 | SENW |
| 31 | FIVE RIVERS USX K 9-21D | 1595 | FNL | 1456 | FWL | 40.32921 | -104.78775 | 1.8 | 4699 | SENW |
| 32 | FIVE RIVERS USX K 9-7D | 1584 | FNL | 1479 | FWL | 40.32924 | -104.78767 | 1.8 | 4698 | SENW |
| 33 | FIVE RIVERS USX K 9-18D | 1573 | FNL | 1503 | FWL | 40.32927 | -104.78758 | 1.8 | 4699 | SENW |
| 34 | FIVE RIVERS USX K 9-2D | 1562 | FNL | 1526 | FWL | 40.32930 | -104.78750 | 1.8 | 4699 | SENW |
| 35 | UPRC 9-316 | 1533 | FNL | 1675 | FWL | 40.32938 | -104.78697 | 1.8 | 4699 | SENW |
| 36 | FIVE 31-9 | 1965 | FNL | 513 | FWL | 40.32823 | -104.79104 | 1.6 | 4699 | SWNW |
| 37 | MONFORT 5-9 | 2014 | FNL | 512 | FWL | 40.32810 | -104.79103 | 1.5 | 4699 | SWNW |
| 44 | UPRR PAN AM 01-61 (P&A) | 1650 | FSL | 1180 | FWL | 40.32421 | -104.79012 | NA | 4727 | NWSW |
| 46 | UPCR 9-1116 | 2337 | FSL | 283 | FWL | 40.32532 | -104.79158 | 1.8 | 4700 | NWSW |
| 47 | UPCR 9-1216 | 2311 | FSL | 262 | FWL | 40.32526 | -104.79165 | 1.7 | 4700 | NWSW |
| 48 | UPRC 9-1416 | 2287 | FSL | 243 | FWL | 40.32519 | -104.79171 | 2.1 | 4701 | NWSW |

NOTE: THE ABANDONED WELL DATA SHOWN IN RED ABOVE WAS OBTAINED FROM COGCC SCOUT CARDS.

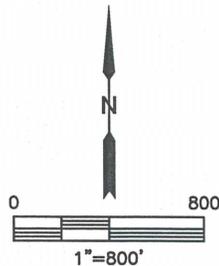

DATE: 3/14/2014
PROJECT#: 2013063