


**WPX Energy Rocky Mountain LLC
SAVAGE RWF 411-25
RULISON FIELD**

**SHL 2465' FNL 1412' FWL (SE/4 NW/4) Section 25 T6S R94W 6th PM
BHL 825' FNL 722' FWL (NW/4 NW/4) Section 25 T6S R94W 6th PM
Garfield County Colorado**

**Formation Tops
(Measured Depths)**

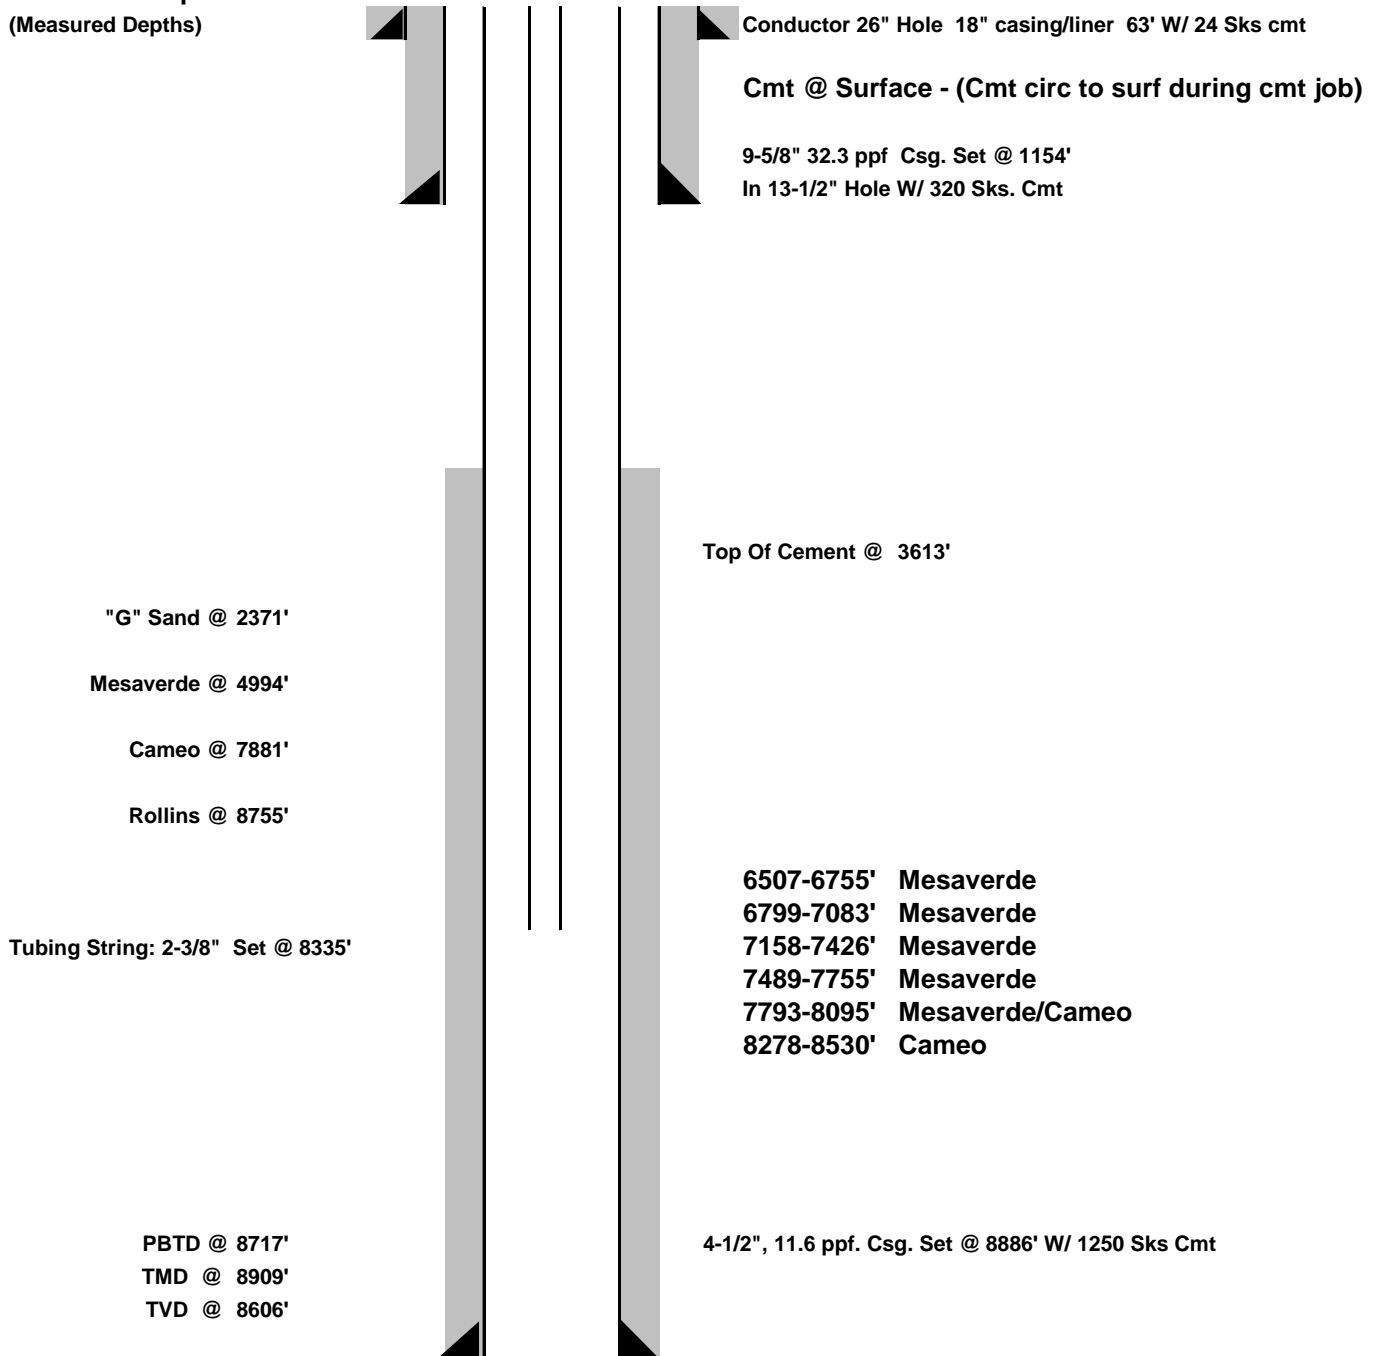

DATE CREATED: 3/26/2014

NOTE: THIS IS NOT TO SCALE.
****FINAL****