


Rothe 13-4

1470' FSL1125' FWL NW SW 4 4N 63W 6th PM
 Lat 40.337727 Long -104.448651 (from footages)
 Weld County, Colorado
 API #05-123-12209

Spud date 12/31/1984

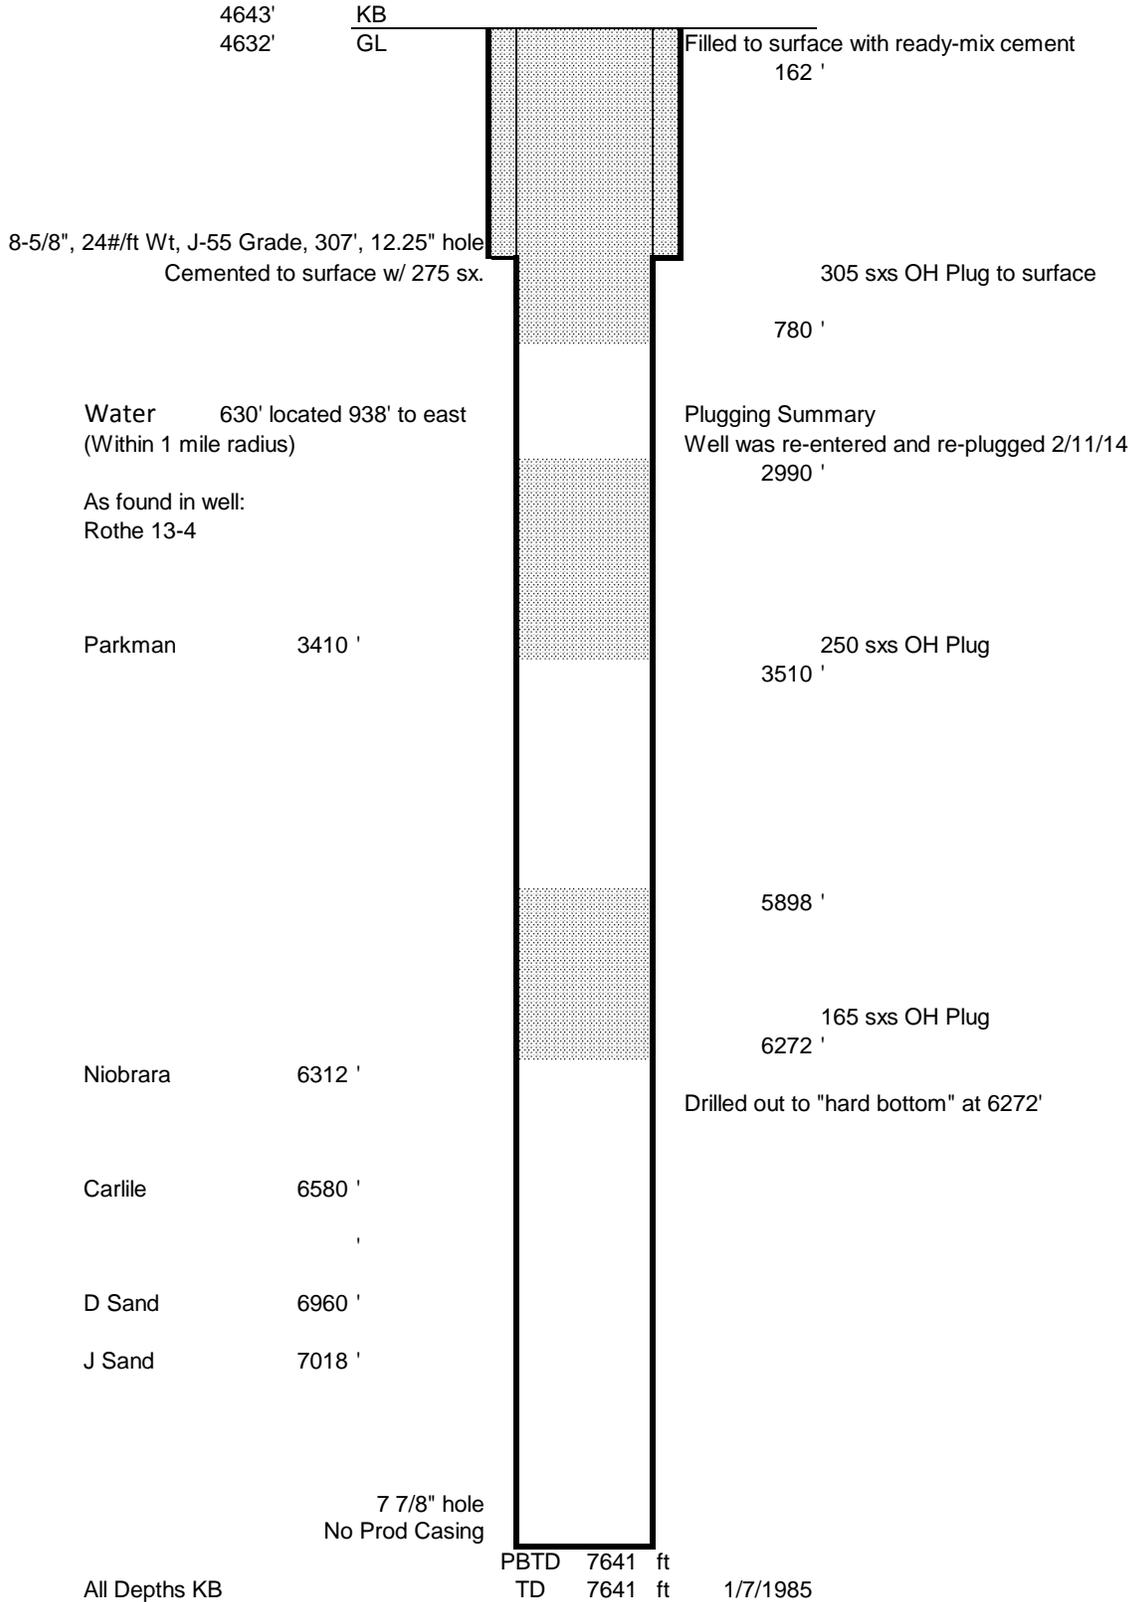

Updated 3/6/2014 jad