

WPX Energy Rocky Mountain LLC

SAVAGE RWF 511-25


RULISON Field

SHL 2454' FNL 1422' FWL (SE/4 NW/4) Section 25 T6S R94W 6th PM

BHL 251' FNL 909' FWL (NW/4 NW/4) Section 25 T6S R94W 6th PM

Garfield County Colorado

Formation Tops
(Measured Depths)

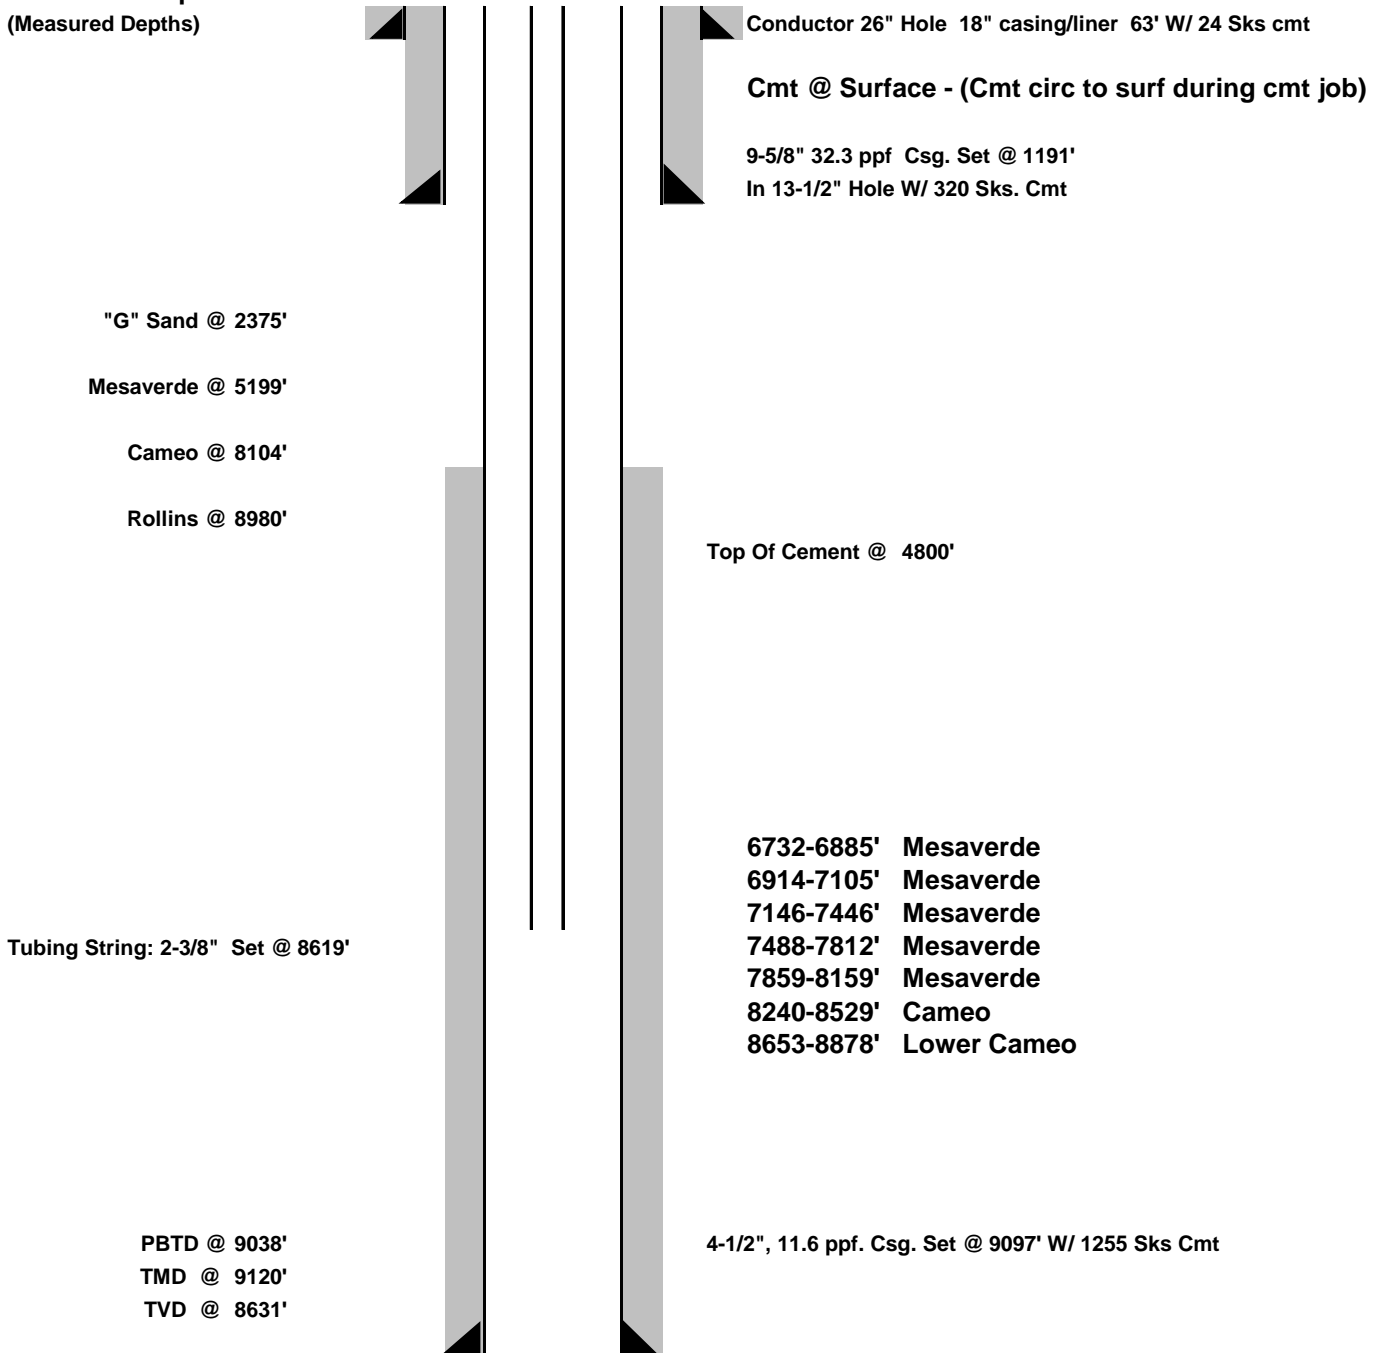

DATE CREATED: 4/15/2014

NOTE: THIS IS NOT TO SCALE.
****FINAL****