noble energy

Frac Wellbore

Well Name: LOUSTALET B15-10
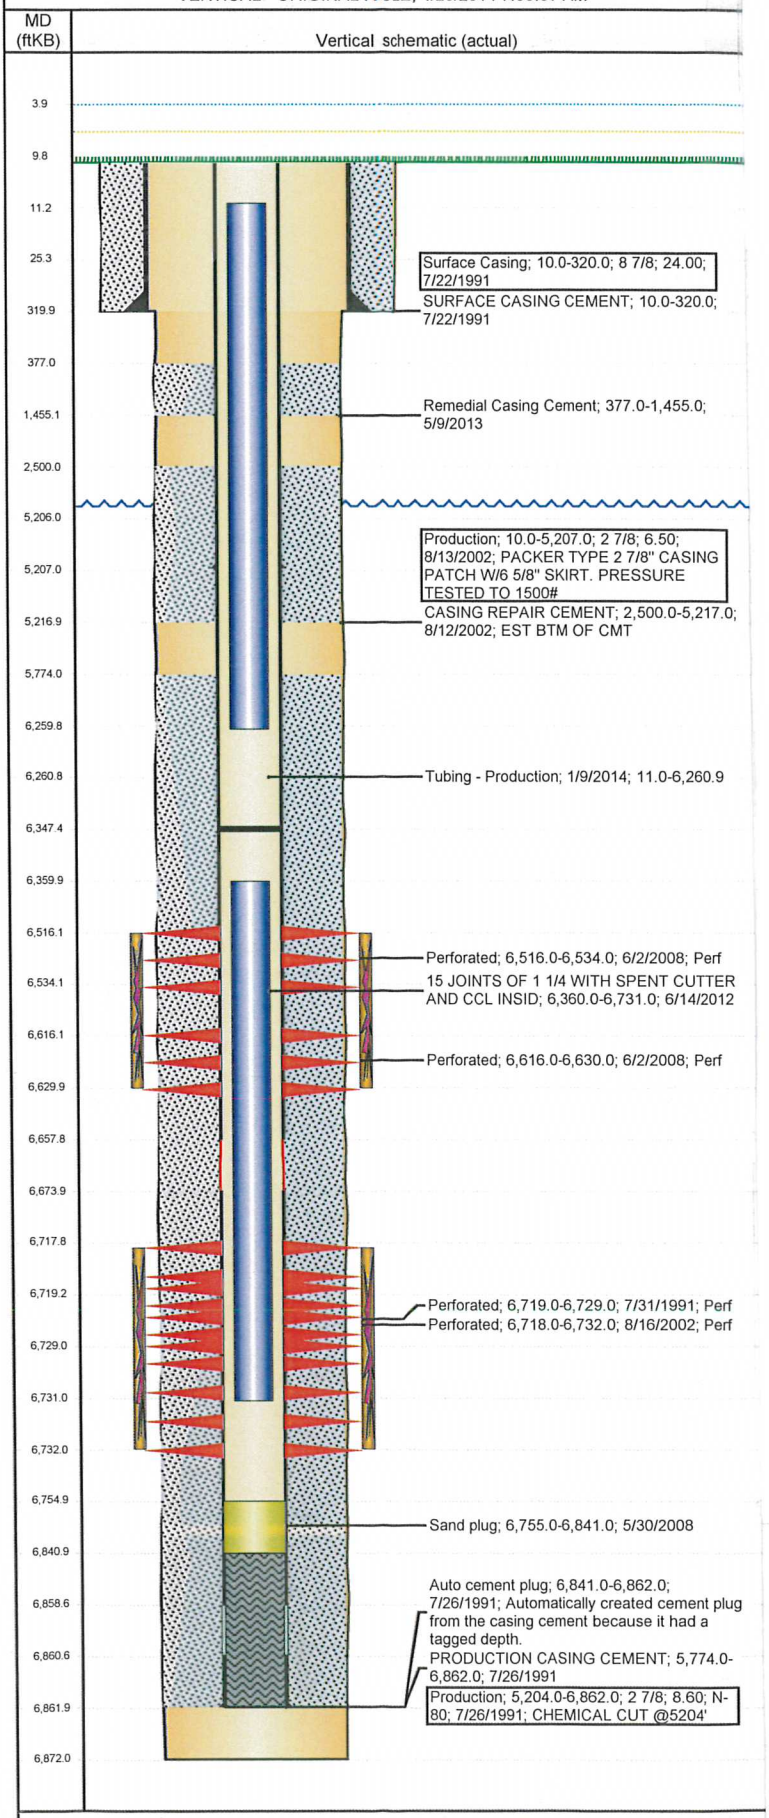
VERTICAL - ORIGINAL HOLE, 4/23/2014 7:00:57 AM