

Before P&A Schematic:

8 5/8" 24# J-55 Surface
Set @ 670' MD

Production TOC @ 5,540' MD

2 3/8" tubing set @ 6,446' MD

4 1/2" 11.6# Production
Set @ 6,741' MD


Zone	Perforation Data	
	Top (ft)	Bottom (ft)
CodeII	6476	6488

After P&A Schematic:

**8 5/8" 24# J-55 Surface
Set @ 670' MD**

**Production TOC @ 5,540' MD
determined by CBL**

**4 1/2" 11.6# Production
Set @ 6,741' MD**

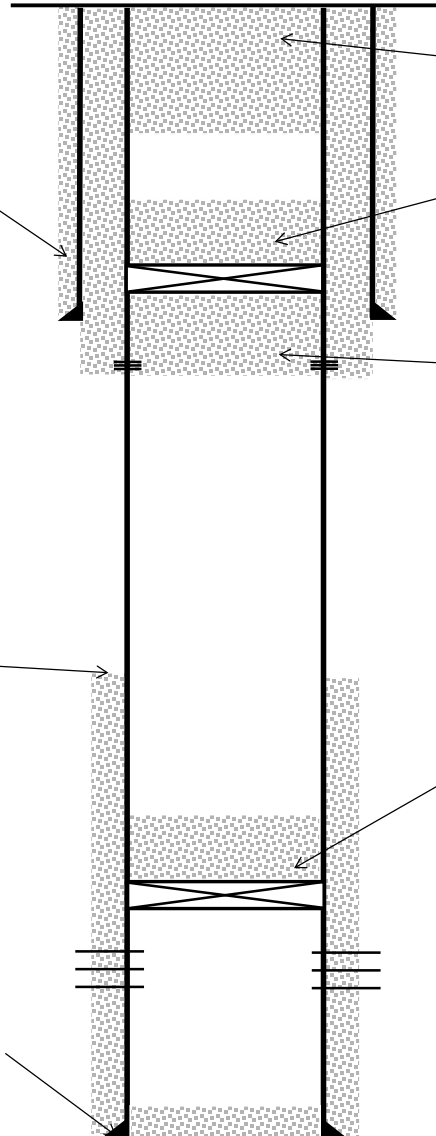

Surface Plug
10 sx, 1.15 Yield, 14.8 ppg cement at surface

5 sx, 1.15 Yield, 14.8 ppg cement on top of CICR

Perf @ 740'
CICR Set @ 640'
Squeeze 150 sx, 1.15 Yield, 14.8 ppg cement behind 4-1/2" csg
Leave 8 sx, 1.15 Yield, 14.8 ppg cement inside 4-1/2" csg f/ CICR to perfs

5 sx, 1.15 Yield, 14.8 ppg cement on top of CIBP @ 6,400' MD

Zone	Perforation Data	
	Top (ft)	Bottom (ft)
Code11	6476	6488