


McPhearson #2

660' FNL1980 FEL NWNE 19 5N 61W 6th PM
Lat 40.391987 Long -104.249875 (from footages)
Weld County, Colorado
API #05-123-05180

Spud date 10/26/1956

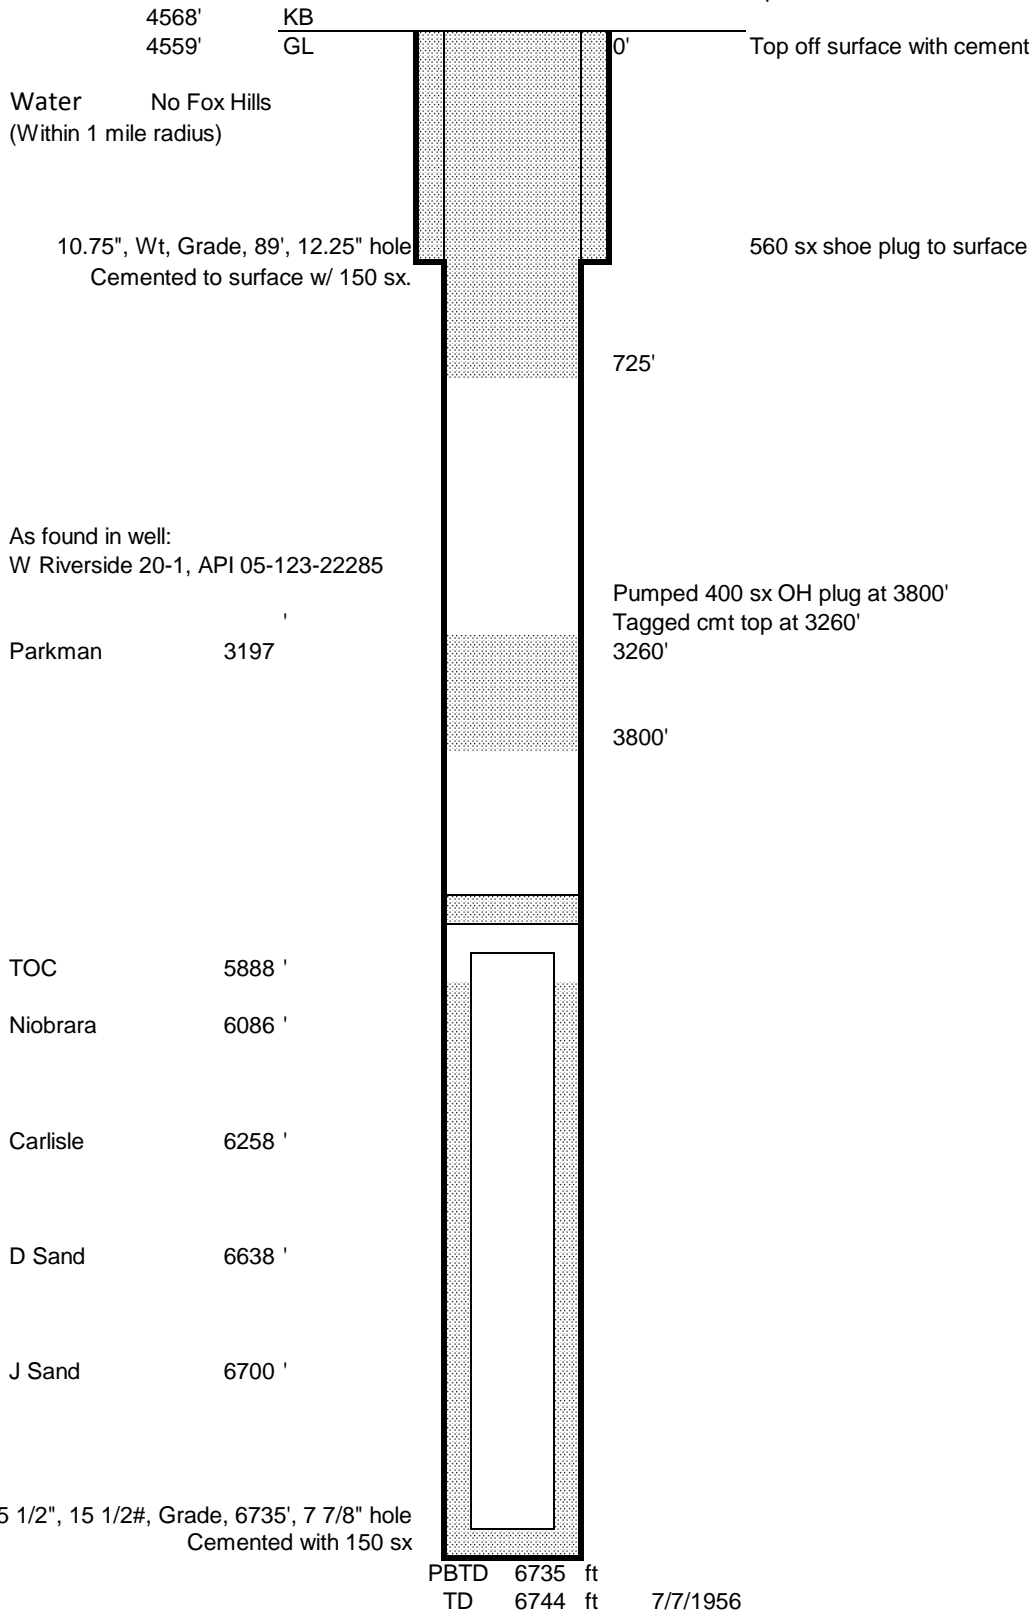

Updated 4/24/2014 jad