





Lat40°, Inc. 1635 Foxtrail Drive, Suite 325 Loveland, CO 970-776-3321

PLUGGED & ABANDONED WELL EXHIBIT

SECTION: 19
TOWNSHIP: 5N
RANGE: 61W

THIS MAP DOES NOT REPRESENT A BOUNDARY SURVEY

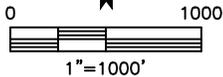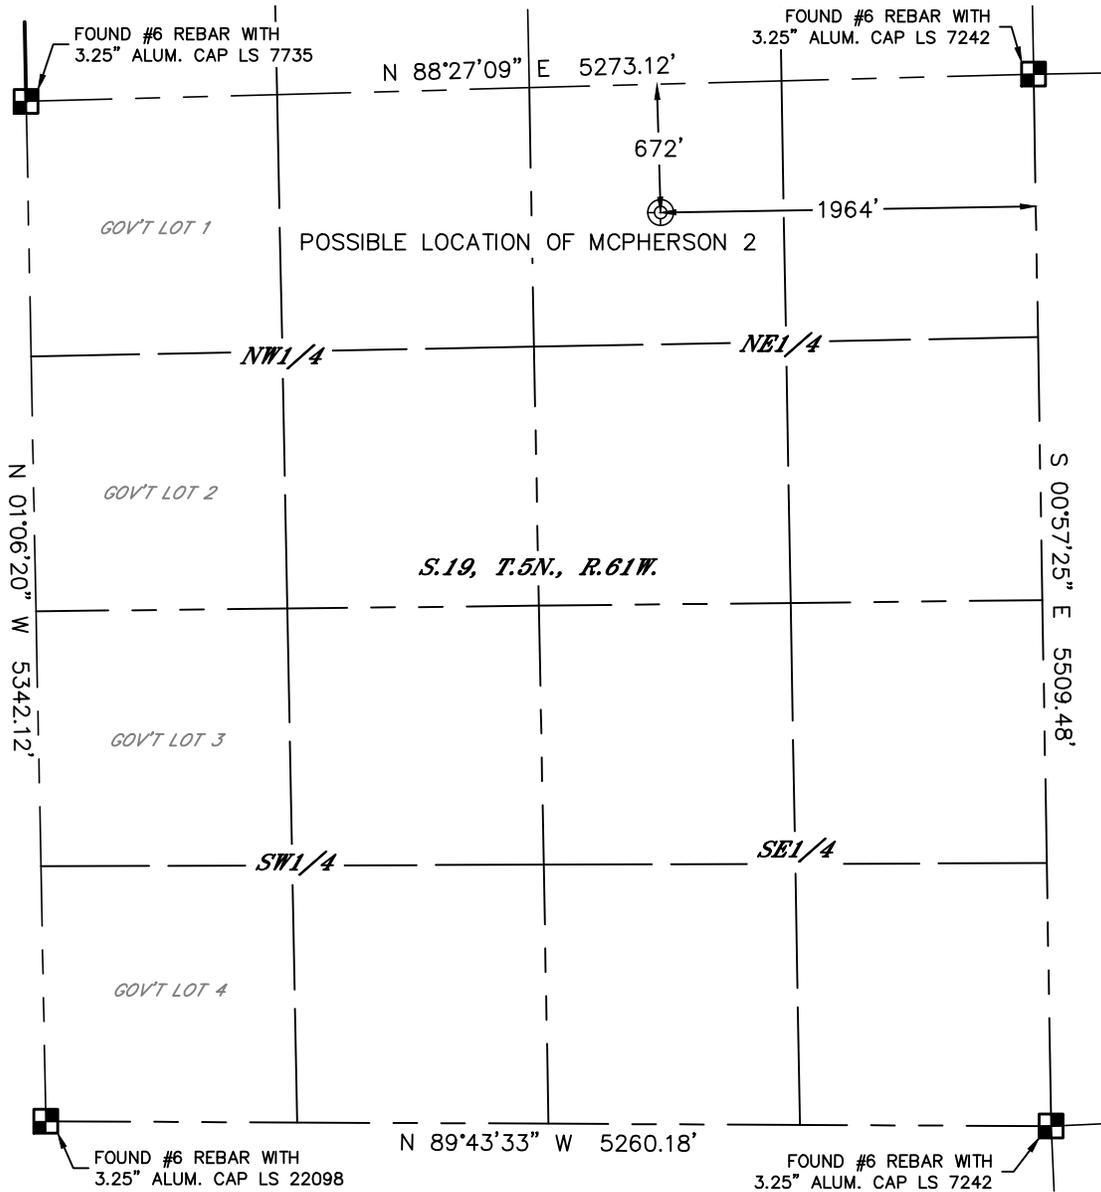

SURFACE LOCATION

LAT: 40.39192°N
LONG: 104.24990°W
PDOP: 2.2
ELEV: 4560'
1/4,1/4: NW1/4NE1/4

SURFACE DESCRIPTION

STRONG METAL DETECTOR SIGNAL FOUND ON THE WEST END OF A LARGE CONCRETE PAD THAT APPEARED TO BE AN OLD PUMP JACK STRUCTURE. EVIDENCE OF OLD FACILITIES ALSO IN THE VICINITY. SET ORANGE LATHE WITH PINK FLAGGING.

LEGEND

- = ALIQUOT MONUMENT AS DESCRIBED
- = CALCULATED POSITION

DATE: 1/24/2014
PROJECT#: 2013173



Lat40°, Inc. 1635 Foxtrail Drive, Suite 325 Loveland, CO 970-776-3321

P&A WELL LOCATION PICTURES

MCPHERSON 2

SECTION: 19
TOWNSHIP: 5N
RANGE: 61W

DATE: 1/22/2014



VIEW NORTH



VIEW WEST



VIEW EAST



VIEW SOUTH

DATE: 1/24/2014
PROJECT#: 2013173