

**Park 41-4****Bonanza Creek Energy, Inc****Plug & Abandon**


API # 05-123-12204

2/21/2013

1155' FNL, 900' FEL, NENE S4 T4N R63W 6th P.M.

Lat 40.34550, Long -104.43689

Weld County, Colorado

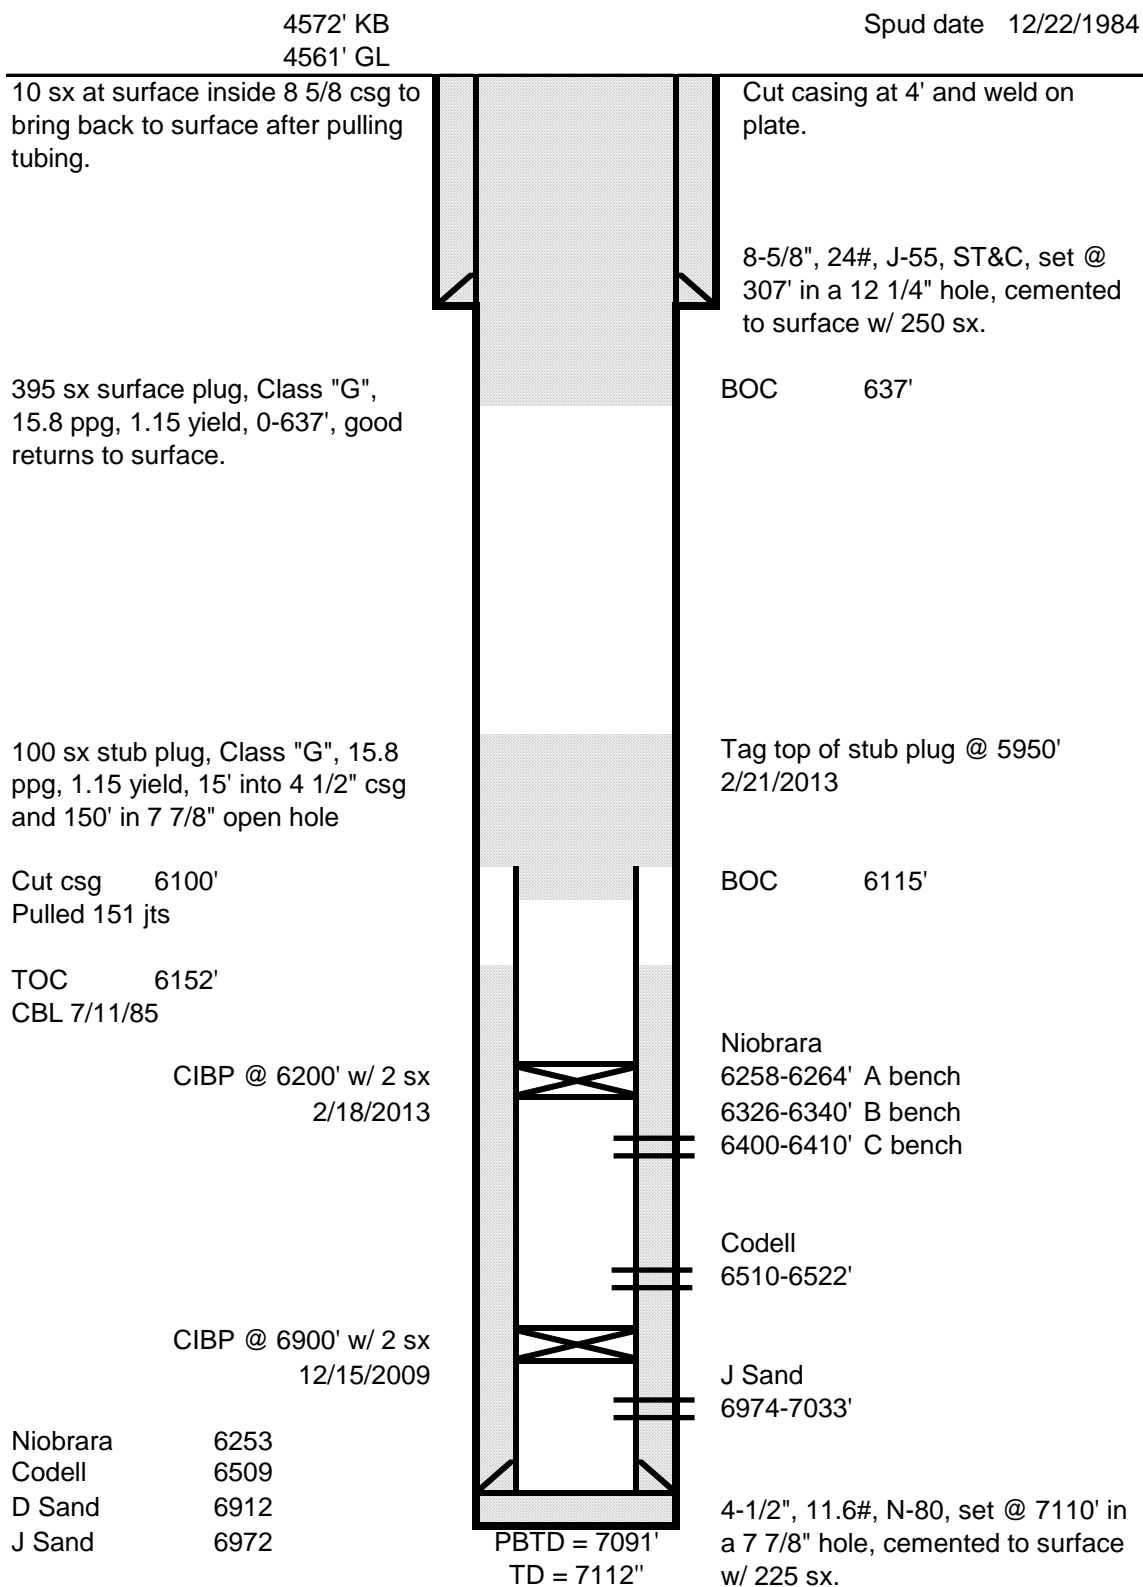

Updated 4/26/2014 srw