

**Alles 41-31****Bonanza Creek Energy, Inc****Csg Repair**

API # 05-123-26114

7/25/2012


600' FNL, 620' FEL, NENE S31 T5N R63W 6th P.M.

Lat 40.36161, Long -104.47181

Weld County, Colorado

4589' KB  
4577' GL

Spud date 8/4/2007

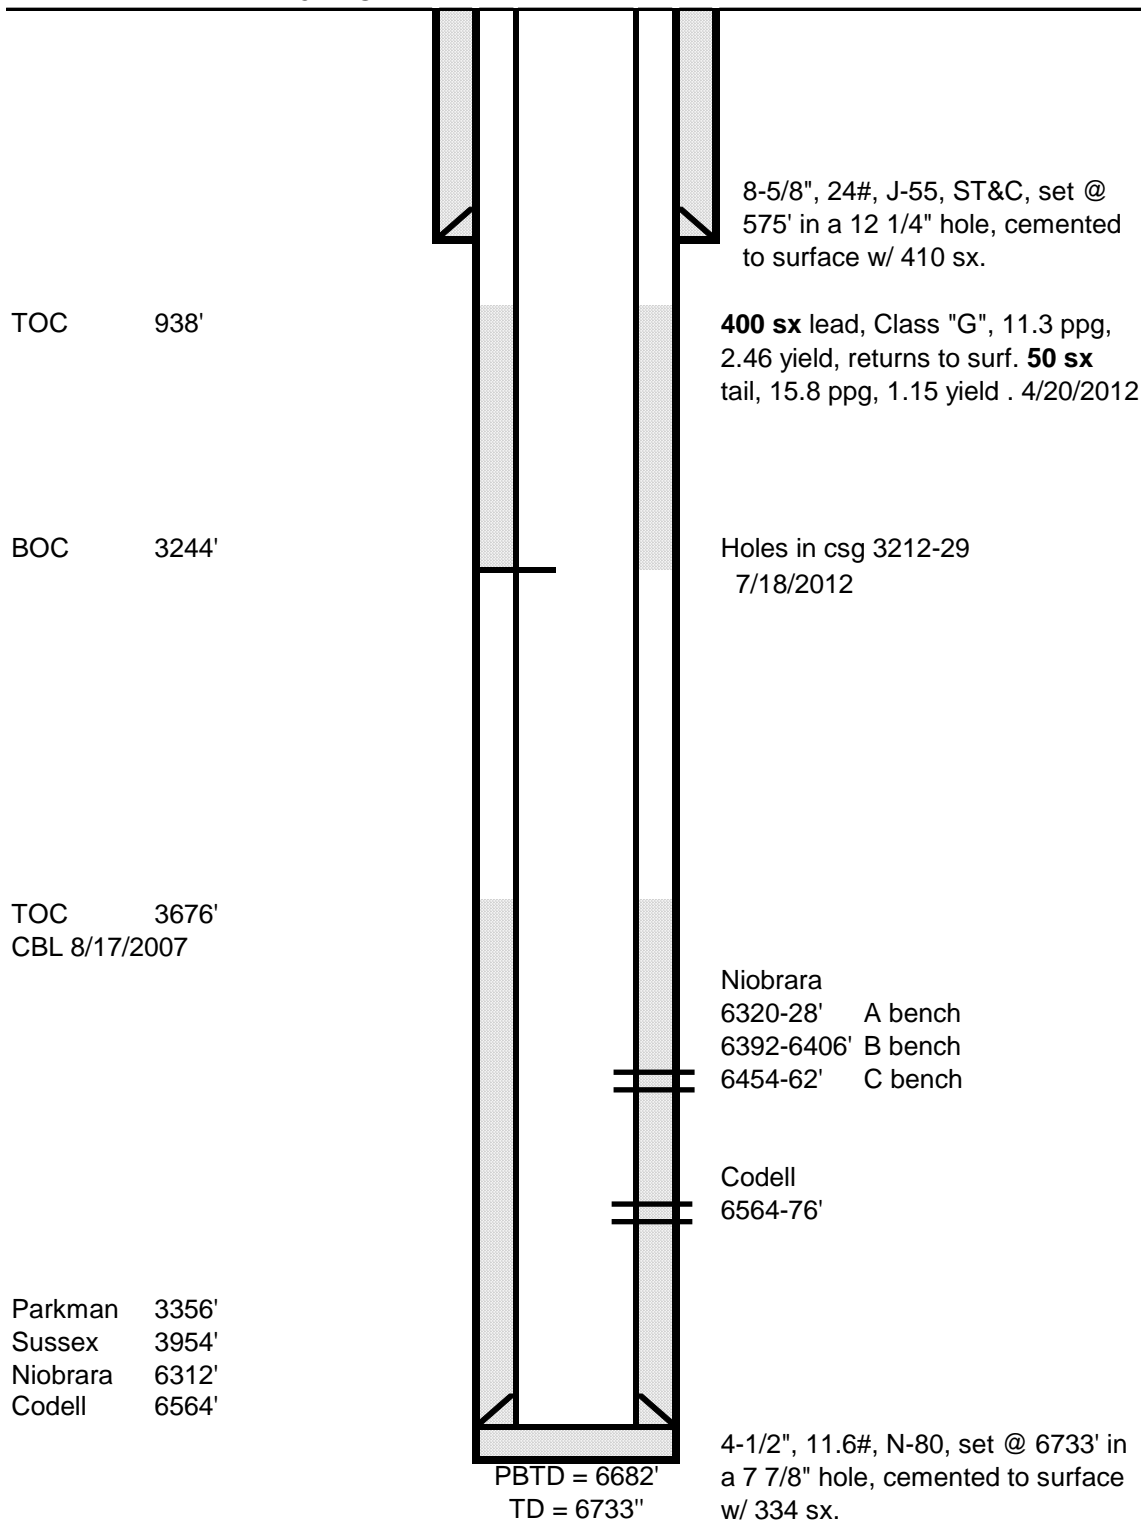

Updated 4/26/2014 srw