COLORADO WELL LOCATION

SECTION 5, TOWNSHIP 9 SOUTH, RANGE 55 WEST OF THE 6TH P.M.
LINCOLN COUNTY, COLORADO

OPERATOR: CASCADE PETROLEUM, LLC
WELL NAME & NO: GAEDE 9S–55W–05–43

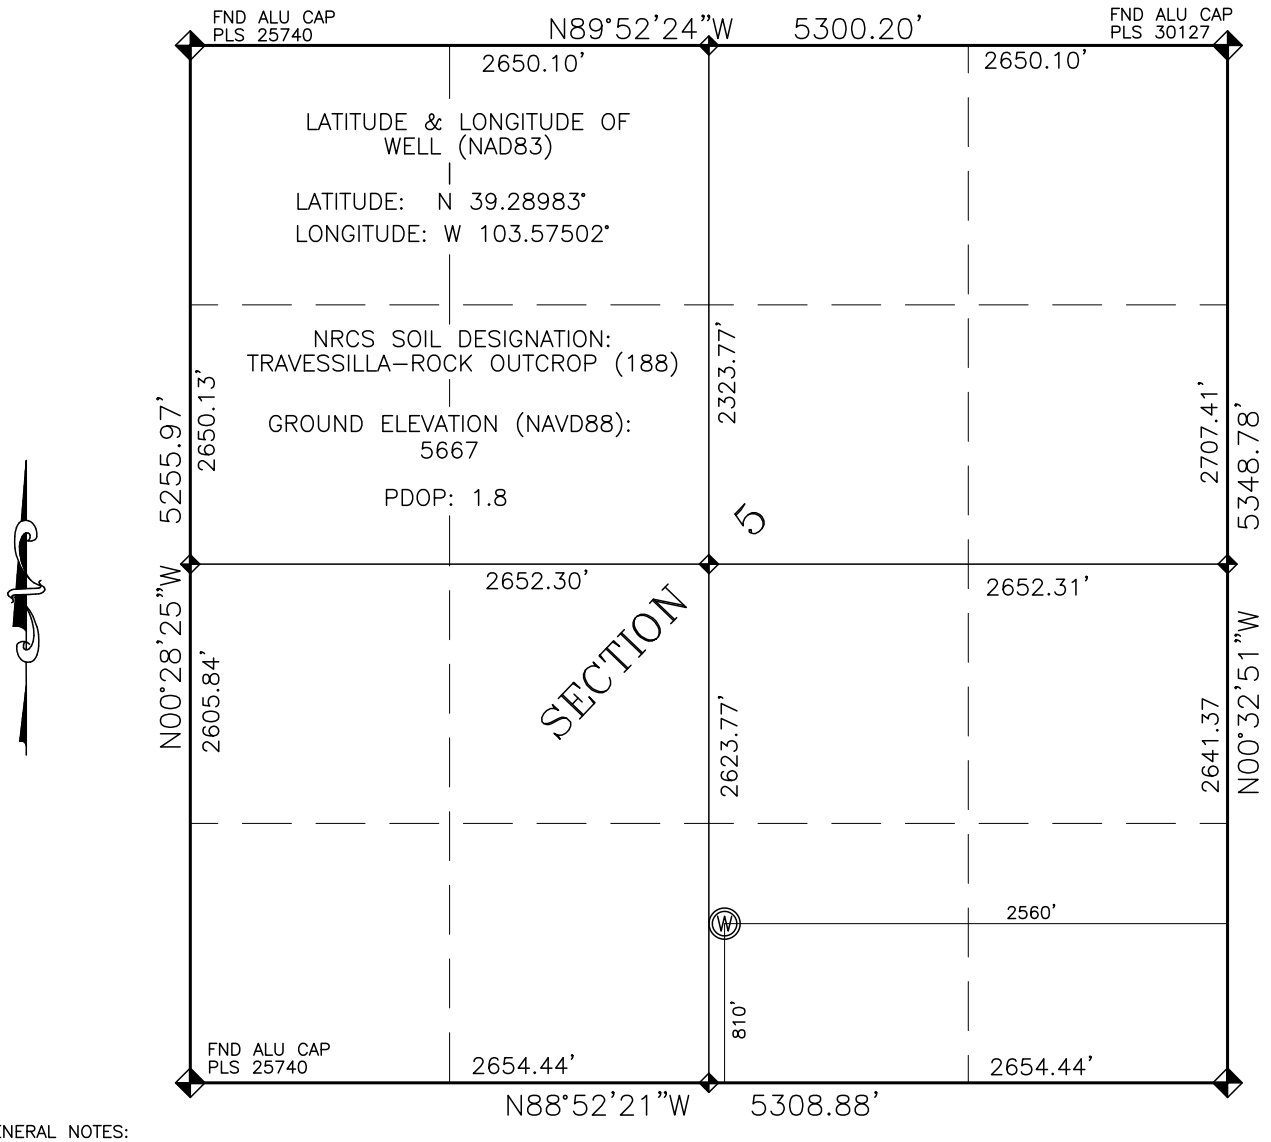

GENERAL NOTES:
1. BASIS OF BEARINGS FOR THIS EXHIBIT IS TRUE NORTH AS DETERMINED FROM GPS OBSERVATIONS AND REFERENCED AS SHOWN HEREON
2. ELEVATIONS SHOWN HEREON WERE DERIVED FROM POST PROCESSED GPS OBSERVATIONS AND ARE NAVD 88 DATUM
3. ALL DISTANCES AND BEARINGS ARE FIELD MEASURED
4. THE GROUND ELEVATION FOR THE WELL WAS MEASURED FROM THE BENCHMARK
5. DISTANCES TO WELLS ARE MEASURED AT 90° FROM SECTION LINES
6. THERE ARE NO IMPROVEMENTS WITHIN 500' OF WELL
7. SURFACE USE WITHIN 500' RADIUS OF WELL IS PASTURE AND CULTIVATED FIELDS

LEGEND:

INDICATES ALU CAP SET AT SECTION CORNER LOCATION PLS 14142 (UNLESS NOTED OTHERWISE)

INDICATES CALCULATED 1/4 CORNER LOCATION

Ⓦ INDICATES LOCATION OF WELL

1000 0 1000

Scale 1" = 1000 ft

SURVEYOR'S CERTIFICATE:
I HEREBY CERTIFY THAT THIS WELL LOCATION CERTIFICATE WAS PREPARED BY ME OR UNDER MY DIRECT SUPERVISION. THAT THE FIELD WORK WAS COMPLETED ON APRIL, 25 2014 FOR AND ON BEHALF OF CASCADE PETROLEUM, LLC. THIS IS NOT A LAND SURVEY PLAT OR AN IMPROVEMENT SURVEY PLAT AND THAT IT IS NOT TO BE RELIED UPON FOR THE ESTABLISHMENT OF SURFACE BOUNDARIES, FENCE, BUILDING OR OTHER FUTURE IMPROVEMENTS.

ROBERT J. RUBINO, P.L.S. 14142

4/29/14
DATE

COLORADO REGISTERED ROBERT J. RUBINO 14142 4/29/14 PROFESSIONAL LAND SURVEYOR

NOTICE: ACCORDING TO COLORADO LAW YOU MUST COMMENCE ANY LEGAL ACTION BASED UPON ANY DEFECT IN THIS SURVEY WITHIN THREE YEARS AFTER YOU FIRST DISCOVER SUCH DEFECT. IN NO EVENT MAY ANY ACTION BASED UPON ANY DEFECT IN THIS SURVEY BE COMMENCED MORE THAN TEN YEARS FROM THE DATE OF CERTIFICATION SHOWN HEREON.

RUBINO SURVEYING
3312 AIRPORT ROAD
BOULDER, CO 80301
(303)464–9515 FAX (303)464–7792
E–MAIL: rubinosurveying@aol.com

DRAWN BY: BR	APPROVED BY: RJR	DATE: APRIL 29, 2014	JOB NO. 14120