

Well

Amoco Ewing #1 Before
API # 05-123-09875
KB: 4,885'
TVD: 4,777'

Surface

8 5/8" 24 #/ft.
N-24
500 sl
cement
12 1/4" hole

Tubing


1 1/2" J5 2 3/8"
SN @ 4,626'
EOT @ 4,647'

Loss

183 J5 3 1/4"
Loss subs 2-6'

Production

4 1/2" 10.5 #/ft.
J-55
200 sl
7 7/8" hole

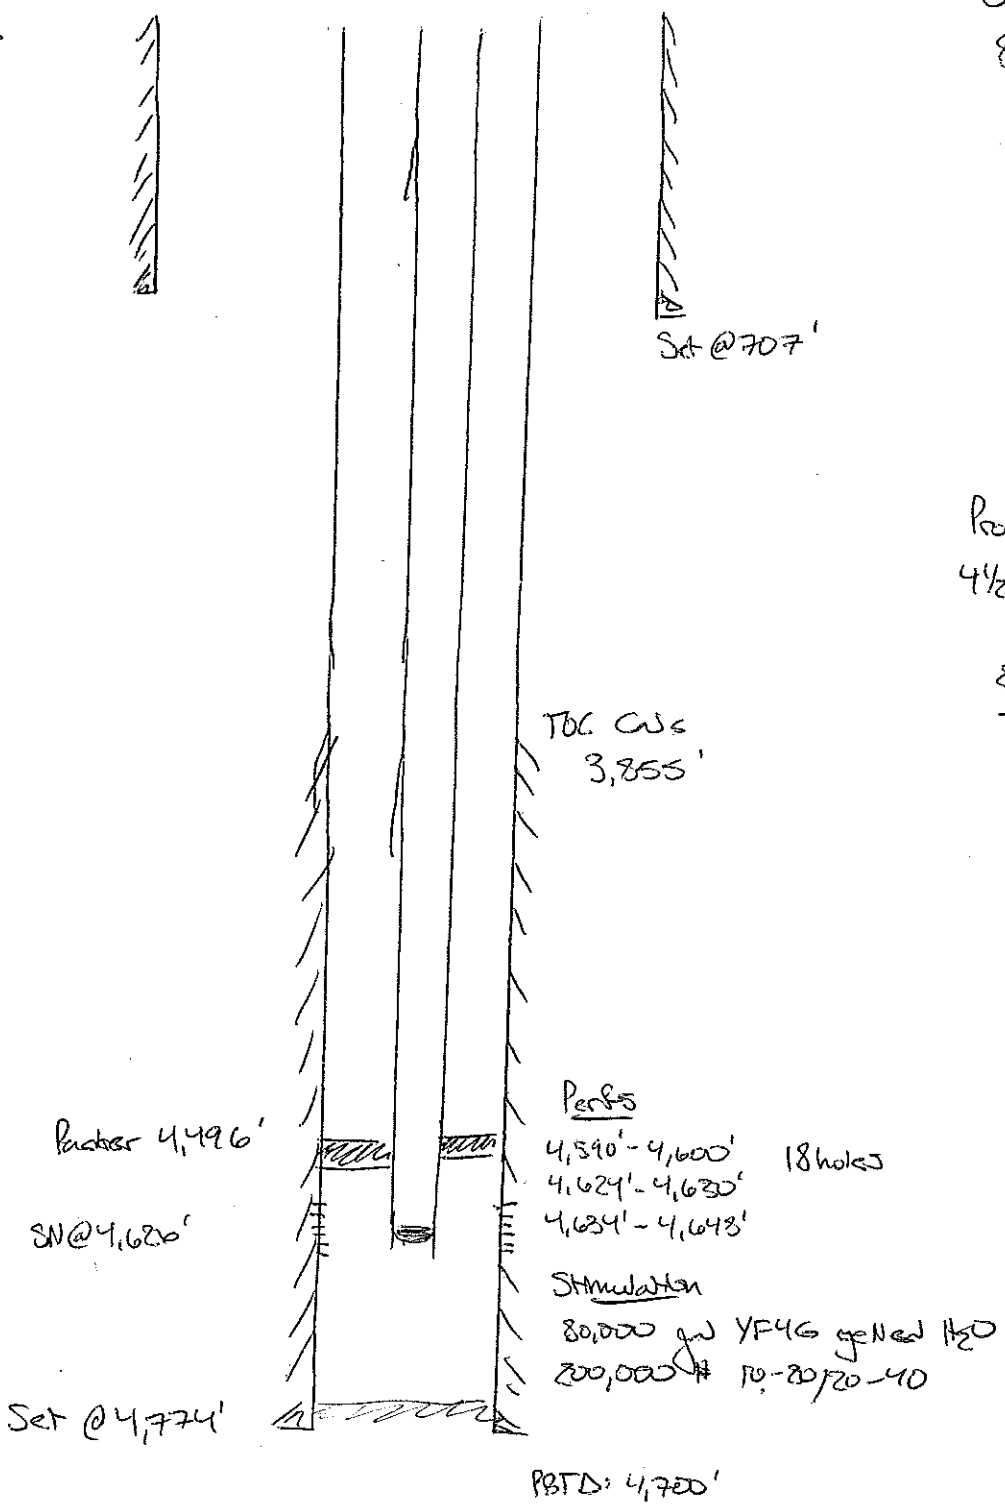

W&N

Amoco-Ewing #1 After

API # 05-123-01875

KB: 4,885'

TVD: 4,777'


Surface

8 5/8" 24 #/ft.

N-24

500 sk cement

12 1/4" hole

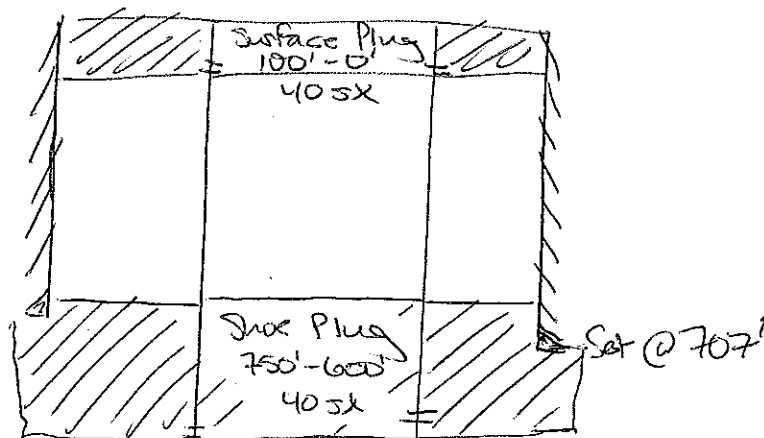

Production

4 1/2" 10.5 #/ft.

J-55

200 sk cement

7 7/8" hole

