


A.D. Jeffers A #1

Latitude/Longitude: N40.11106000, W -104.88386000:
Township/Range: 27 002-N
Swnw-27-2N-67W
County: Weld, State: CO
Spud Date: 10/14/1985
Total Depth: 8230

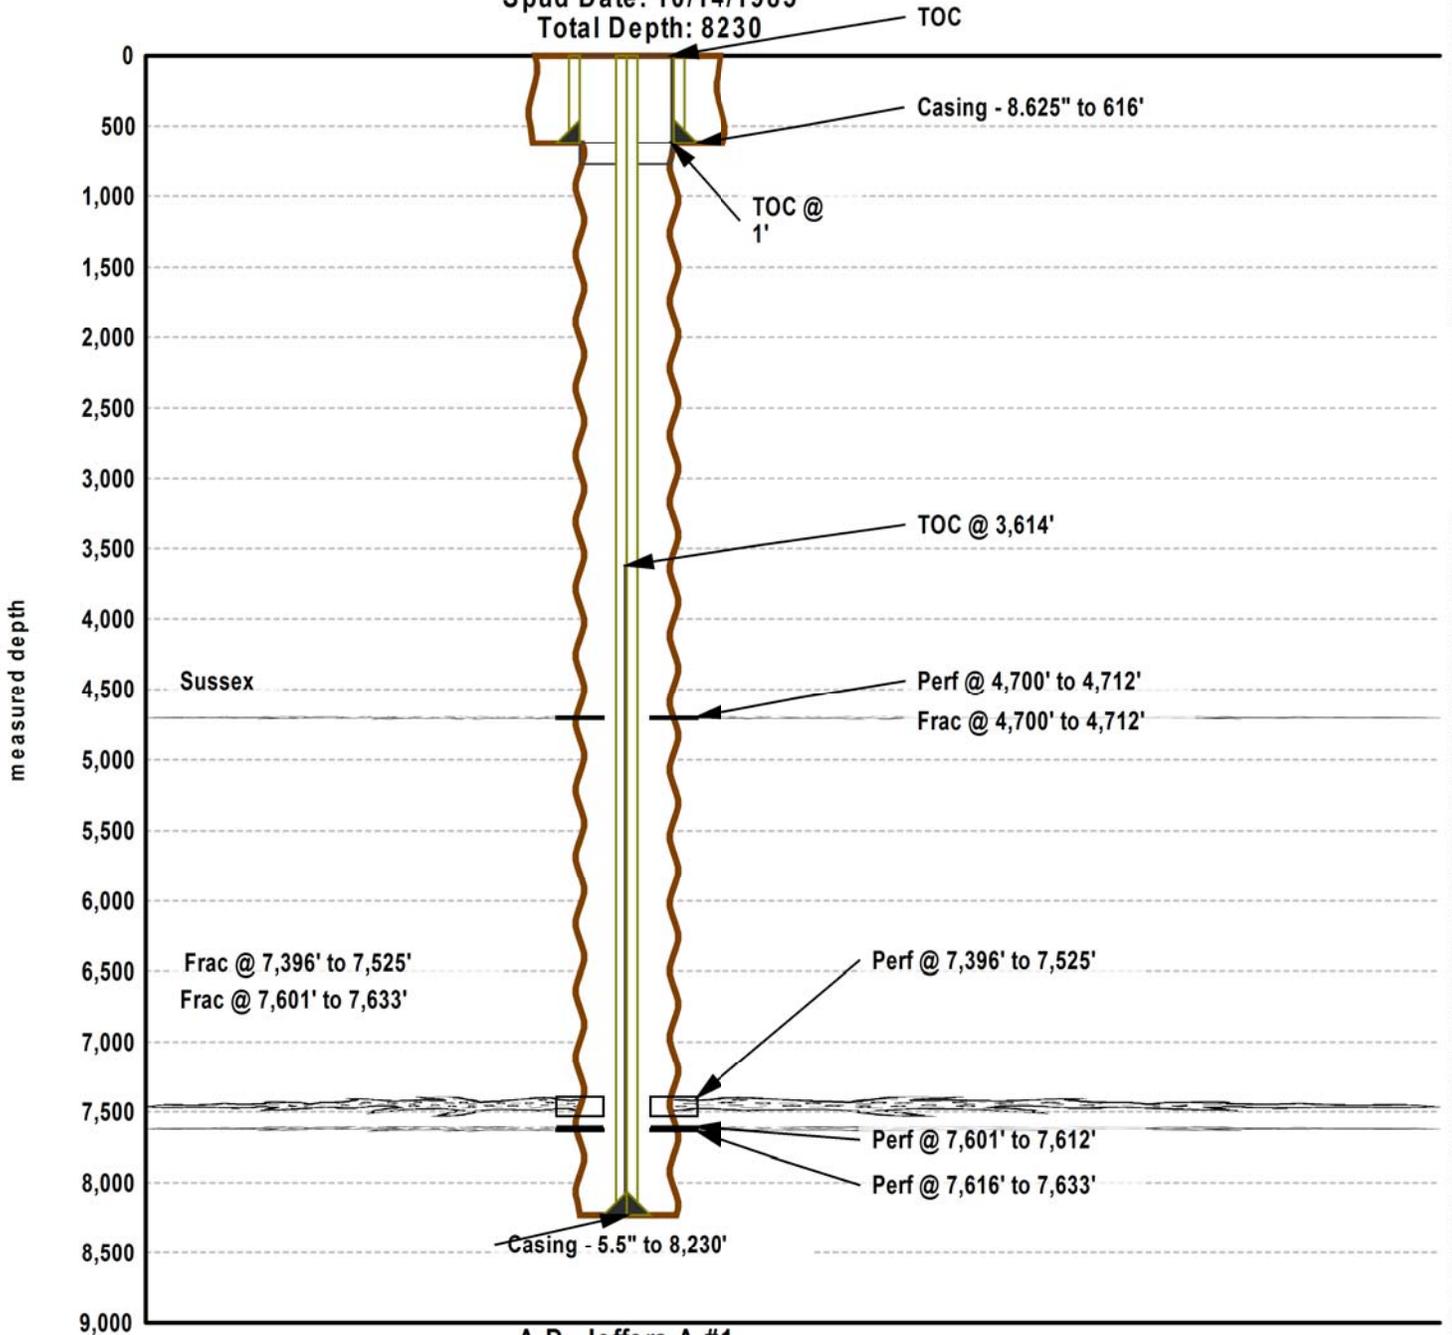

A.D. Jeffers A #1
Initial Completion: 9/26/1992
Proposed Depth: 8220 Plug Back Depth: 8148