


**KERR-MCGEE OIL AND GAS ONSHORE LP**

**MCLAUGHLIN 34-8  
SW SE 8 3N 67W -- --  
WELD,COLORADO  
05/05/2014**

**AREA: N2      ROUTE: N21    Spud: 01/09/1994    WINS No.: 76814    AFE/WO#: 2096222    API#: 0512317775**

**GL: 4834    KB: 4844    MTD: 7281    TVD: 7281    LOG MD: 7206    PBMD: 7224    PBTVD: 7224**

**Directions: CR 34 & CR 17, W 5/10, N 1/10, E INTO. MOVE HOT WIRE FENCE. TIGHT TURN**

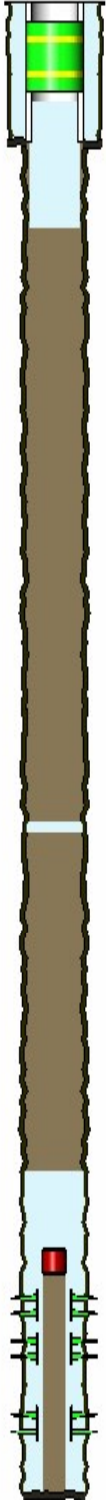

<u>HOLE SECTIONS</u>	<u>Size</u>	<u>Top</u>	<u>Btm</u>	<u>TD Date</u>
SURFACE	12.25	10	400	01/09/1994
PRODUCTION	7.88	400	7281	01/14/1994

<u>TUBULARS</u>	<u>Tool Type</u>	<u>Joints</u>	<u>Size</u>	<u>Weight</u>	<u>Grade</u>	<u>Thread</u>	<u>Top D</u>	<u>Bottom D</u>
SURFACE CASING	Casing	9	8.63	24	K-55		10	387
BRIDGE PLUG	Wellbore Equipment	1	3.50				6800	6801
BRIDGE PLUG	Cast Iron Bridge Plu	1	8.63				100	101

<u>CEMENT JOBS</u>	<u>Stage</u>	<u>Sacks</u>	<u>Cement Jobs</u>	<u>Top D</u>	<u>Btm D</u>	<u>cbl</u>
SURFACE CASING	STAGE 1	270	G	10	400	No
PRODUCTION CASING	STAGE 1	150	G	6506	7281	Yes
PRODUCTION CASING	ABANDONMENT PLUC	20	LEAD FRESH WATER	6352	6800	No
PRODUCTION CASING	ABANDONMENT PLUC	370	LEAD FRESH WATER	4330	3580	No
SURFACE CASING	ABANDONMENT PLUC	270	LEAD FRESH WATER	150	890	No

<u>PERFORATIONS</u>	<u>Formation</u>	<u>Zone</u>	<u>Top</u>	<u>Btm</u>	<u>Date</u>	<u>Reason</u>	<u>Comments</u>
	NIOBRARA		6876	6882	01/18/1994	PRODUCTION	
	NIOBRARA		6941	6946	01/18/1994	PRODUCTION	
	CODELL		7144	7163	03/09/2007	PRODUCTION	
	CODELL		7146	7156	01/18/1994	PRODUCTION	

Comments: