


KERR-MCGEE OIL AND GAS ONSHORE LP

**SEKICH FARMS 9-18
NE SE 18 3N 67W -- --
WELD,COLORADO
05/05/2014**

AREA: N2 ROUTE: N21 Spud: 02/27/1994 WINS No.: 74162 AFE/WO#: 2096675 API#: 0512318010

GL: 4825 KB: 4835 MTD: 7312 TVD: 7312 LOG MD: PBMD: 7273 PBTVD: 7273

Directions: CR 32 & CR 13, E 8/10, N 4/10, E 1/10 INTO.

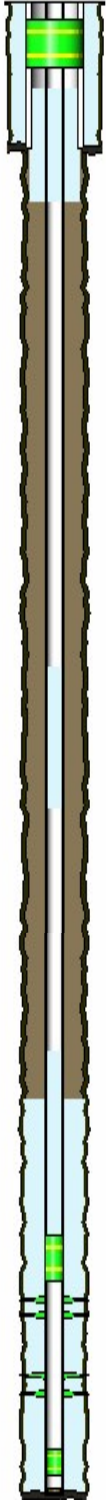

<u>HOLE SECTIONS</u>	<u>Size</u>	<u>Top</u>	<u>Btm</u>	<u>TD Date</u>				
SURFACE	12.25	10	570	02/28/1994				
PRODUCTION	7.88	570	7312	03/05/1994				
<u>TUBULARS</u>	<u>Tool Type</u>	<u>Joints</u>	<u>Size</u>	<u>Weight</u>	<u>Grade</u>	<u>Thread</u>	<u>Top D</u>	<u>Bottom D</u>
SURFACE CASING	Casing	13	8.63	24			10	567
PRODUCTION CASING	Casing	235	2.88	6.5	J-55		10	7271
		1	2.88				7271	7273
	Casing	1	2.88	6.5	J-55		7273	7299
	Casing Guide Shoe	1	2.88				7299	7300
BRIDGE PLUG	Cast Iron Bridge Plu	1	2.88				6900	6901
BRIDGE PLUG	Cast Iron Bridge Plu	1	8.63				94	96
<u>CEMENT JOBS</u>	<u>Stage</u>	<u>Sacks</u>	<u>Cement Jobs</u>			<u>Top D</u>	<u>Btm D</u>	<u>cbl</u>
SURFACE CASING	STAGE 1	395	NEAT			10	570	No
PRODUCTION CASING	STAGE 1	210	PREMIUM			6110	7312	Yes
PRODUCTION CASING	ABANDONMENT PLUC	20	DISPLACE FRESH WATER			5827	6900	No
PRODUCTION CASING	ABANDONMENT PLUC	300	LEAD	FRESH WATER		3593	4422	No
SURFACE CASING	ABANDONMENT PLUC	190	LEAD	FRESH WATER		220	880	No
<u>PERFORATIONS</u>	<u>Formation</u>	<u>Zone</u>	<u>Top</u>	<u>Btm</u>	<u>Date</u>	<u>Reason</u>	<u>Comments</u>	
	NIOBRARA		6952	6955	03/10/1994	PRODUCTION		
	CODELL		7162	7172	10/30/2000	PRODUCTION		
	CODELL		7164	7167	03/10/1994	PRODUCTION		

Comments: