


From: [Arthur Koepsell - DNR](#)
To: ["regulatory@petro-fs.com"](mailto:regulatory@petro-fs.com)
Subject: Bayswater Craig 44-18 Rule 609 Sundry Notice Document # 400564979
Date: Tuesday, April 29, 2014 4:03:00 PM
Attachments: [image002.png](#)

Sonia,

A review of DWR data found on the COGCC web site indicates that there is at least one additional water well within 1/2 mile of the Craig 44-18. The water well is receipt # 9057085, permit # 24566. Could you please provide either sampling data or documentation indicating why a sample was not collected. Please see the map below.

Thanks,

Arthur

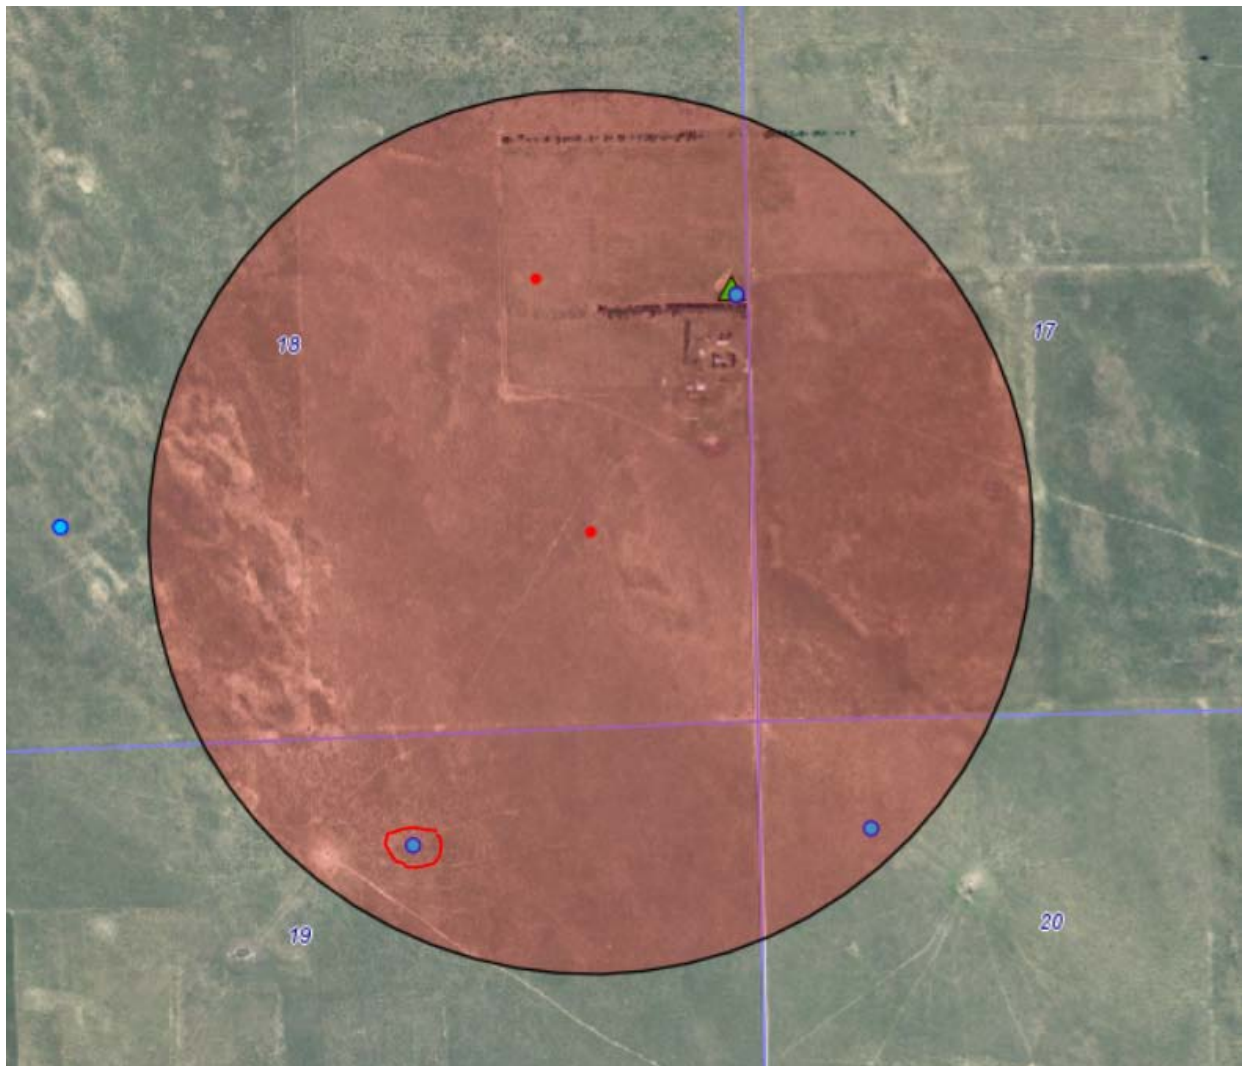

Arthur W. Koepsell, P.G.
Environmental Data Analyst



COLORADO
Oil & Gas Conservation
Commission
Department of Natural Resources

P 303.894.2100 x5148 | F 303.894.2109
1120 Lincoln Street, Suite 801, Denver, CO 80203
arthur.koepsell@state.co.us | www.colorado.gov/cogcc