


**WPX Energy Rocky Mountain LLC
BOSELY SG 414-22
GRAND VALLEY Field
SHL 609' FSL 1545' FWL (SE/4 SW/4) Section 22 T7S R96W 6th PM
BHL 201' FSL 248' FWL (SW/4 SW/4) Section 22 T7S R96W 6th PM
Garfield County Colorado**

**Formation Tops
(Measured Depths)**

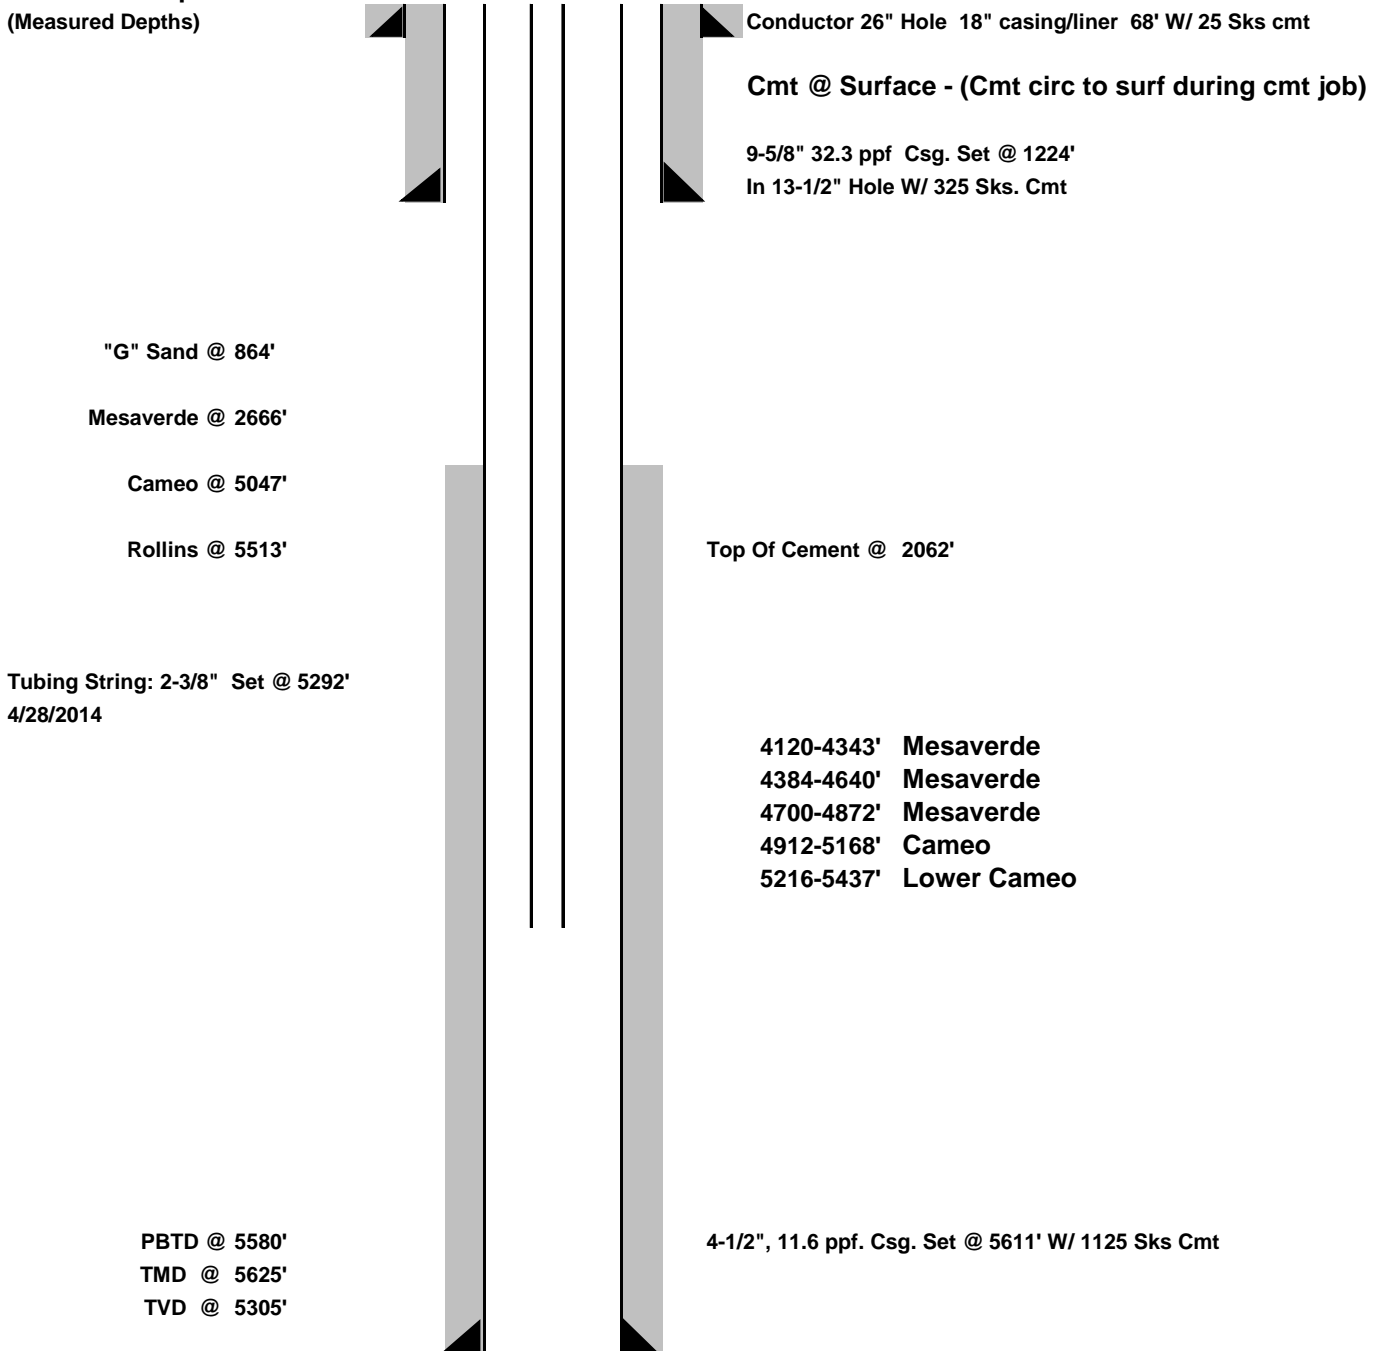

DATE CREATED: 5/6/2014

NOTE: THIS IS NOT TO SCALE.
****FINAL****