

KERR-MCGEE OIL AND GAS ONSHORE LP
INVESTMENT-USX VV 7-17
C NE 7 1N 67W 1,318' FNL 1,313' FEL
WELD,COLORADO
05/07/2014

AREA: W3

ROUTE: W32 Spud: 06/24/1978

WINS No.: 02143

AFE/WO#: 88499200

API#: 0512309524

GL: 5078

KB: 5088

MTD:


TVD:

LOG MD:

PBMD: 8308

PBTVD:

Directions: CR 12 & CR 15, W 2/10, S 1/10 INTO

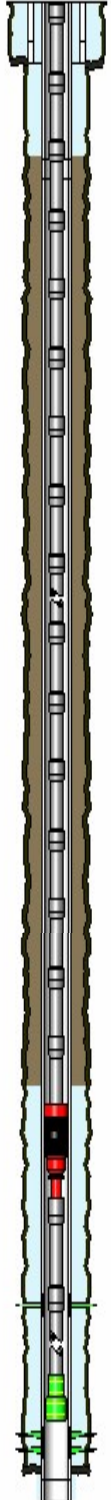

<u>HOLE SECTIONS</u>	<u>Size</u>	<u>Top</u>	<u>Btm</u>	<u>TD Date</u>
SURFACE	12.25	10	256	06/24/1978
PRODUCTION	7.88	256	8352	07/04/1978

<u>TUBULARS</u>	<u>Tool Type</u>	<u>Joints</u>	<u>Size</u>	<u>Weight</u>	<u>Grade</u>	<u>Thread</u>	<u>Top D</u>	<u>Bottom D</u>
Surface	Casing	6	8.62	24.00			10	253
	Casing	1	8.62				253	254
Production	Casing	21	4.50	11.60			10	880
	Casing	1	4.50				880	882
	Casing	183	4.50	11.60			882	8348
	Casing	1	4.50				8348	8350
PRODUCTION TUBING	Tubing	231	2.38	4.70	J-55	8RD EUE	10	7125
	Packer	1	3.75				7125	7131
	Tubing	34	2.38	4.70	J-55	8RD EUE	7131	8184
	XN Profile Nipple	1	2.38				8184	8185
	Notched Collar	1	3.06				8185	8186

<u>CEMENT JOBS</u>	<u>Stage</u>	<u>Sacks</u>	<u>Cement Jobs</u>	<u>Top D</u>	<u>Btm D</u>	<u>cbl</u>
Surface	SURFACE CASING CE	10206	Lead	10	254	No
Production	PRODUCTION CASING	9072	Lead	7000	8350	No
Production	CEMENT SQUEEZE	11340	Squeeze	10	880	No
Production	REMEDIAL CEMENT	105	LEAD FRESH WATER	7296	7406	Yes

<u>PERFORATIONS</u>	<u>Formation</u>	<u>Zone</u>	<u>Top</u>	<u>Btm</u>	<u>Date</u>	<u>Reason</u>	<u>Comments</u>
	Unknown		7405	7406	04/16/2014	CEMENT SQUEEZE	
	Unknown	CODELL	7778	7788	12/30/2000		-- [WV Data Migration]
	Unknown	J SAND	8224	8242	08/16/1978		-- [WV Data Migration]

Comments: