

Crisman #1-26

General Location:


Sene-26-2S-62W

Latitude/Longitude: N39.84934500, W -104.28466500:

County: Adams, State: CO

Spud Date: 9/12/1972

Total Depth: 7250

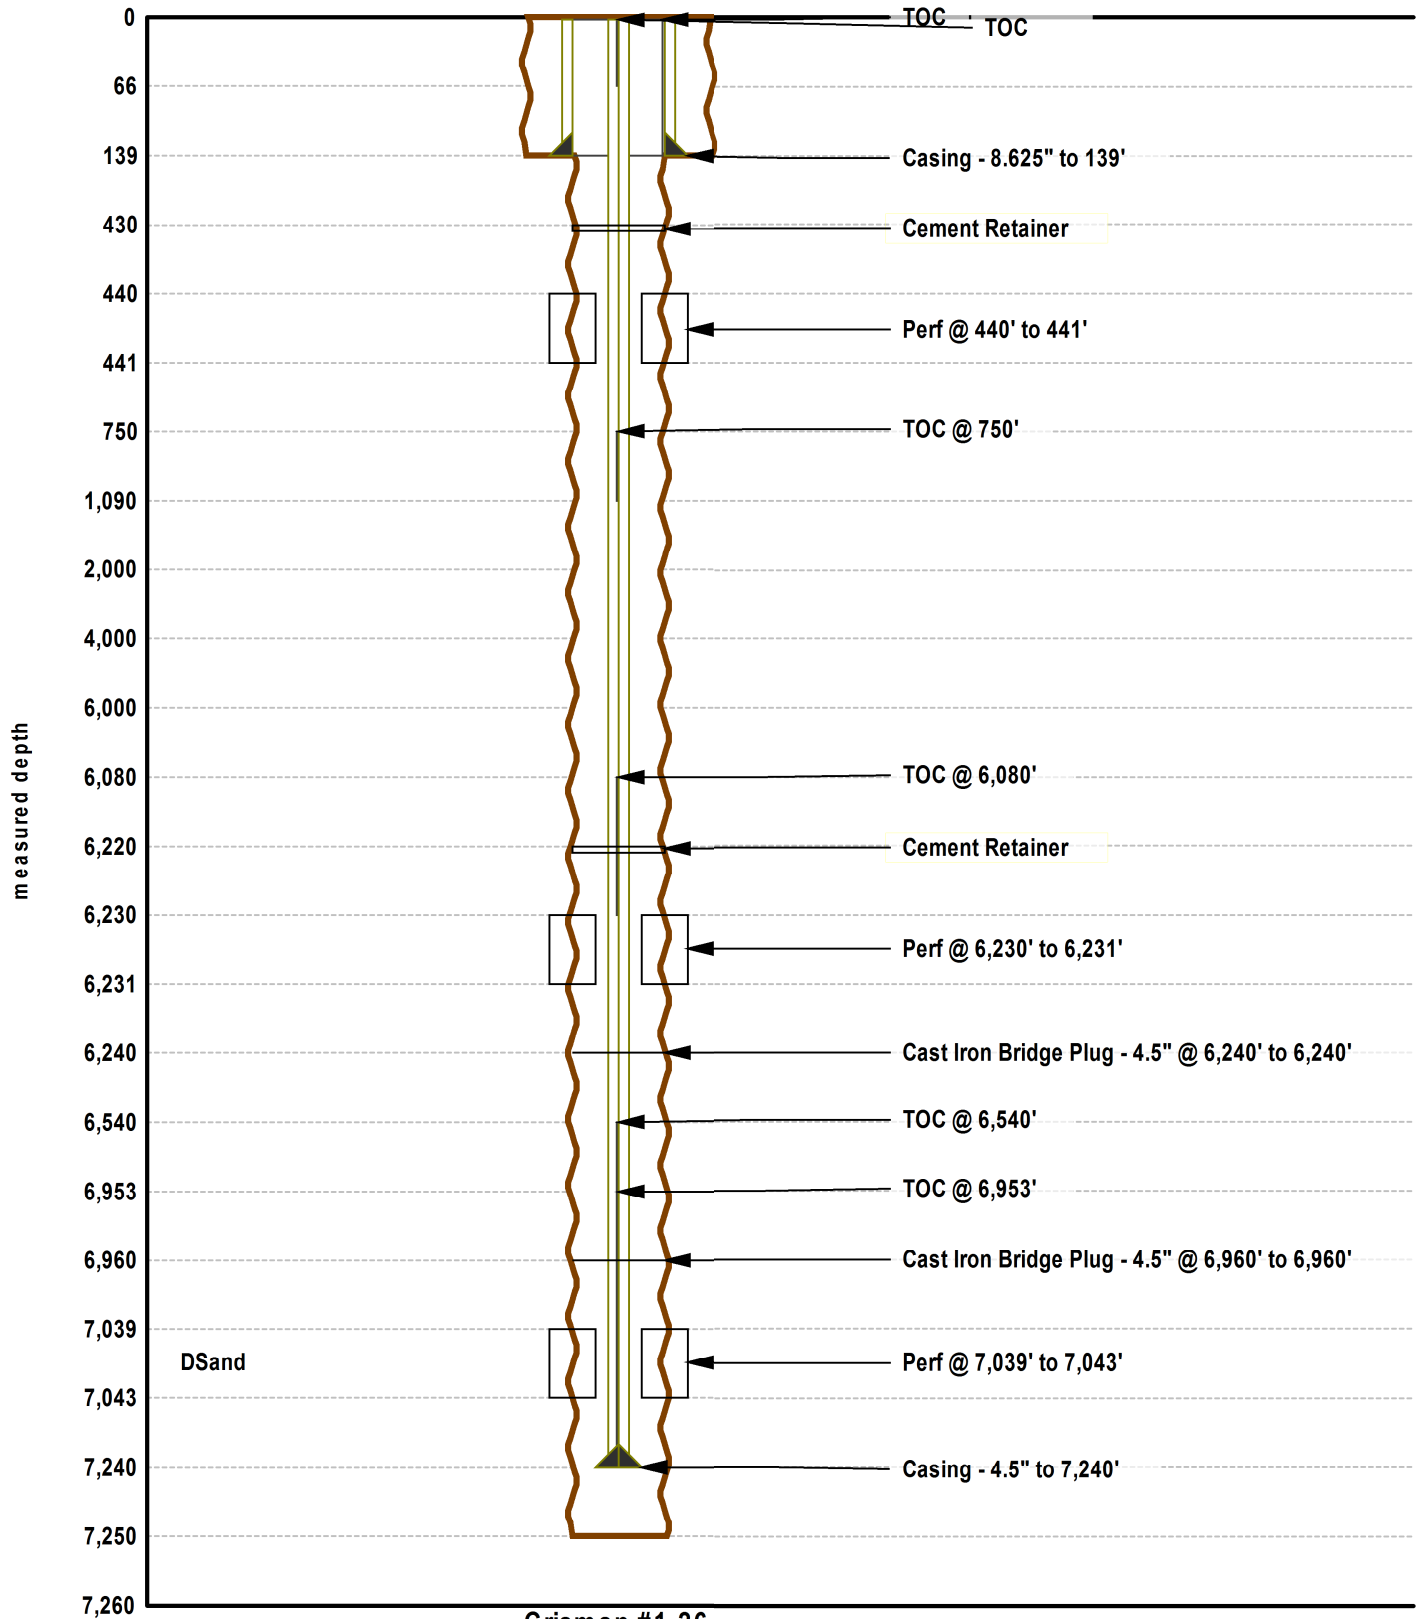

Crisman #1-26

Initial Completion: 10/3/1972