



Keystone 2-13  
NW/4 Sec. 13-T33S-R44W  
API # 05-009-06624-00

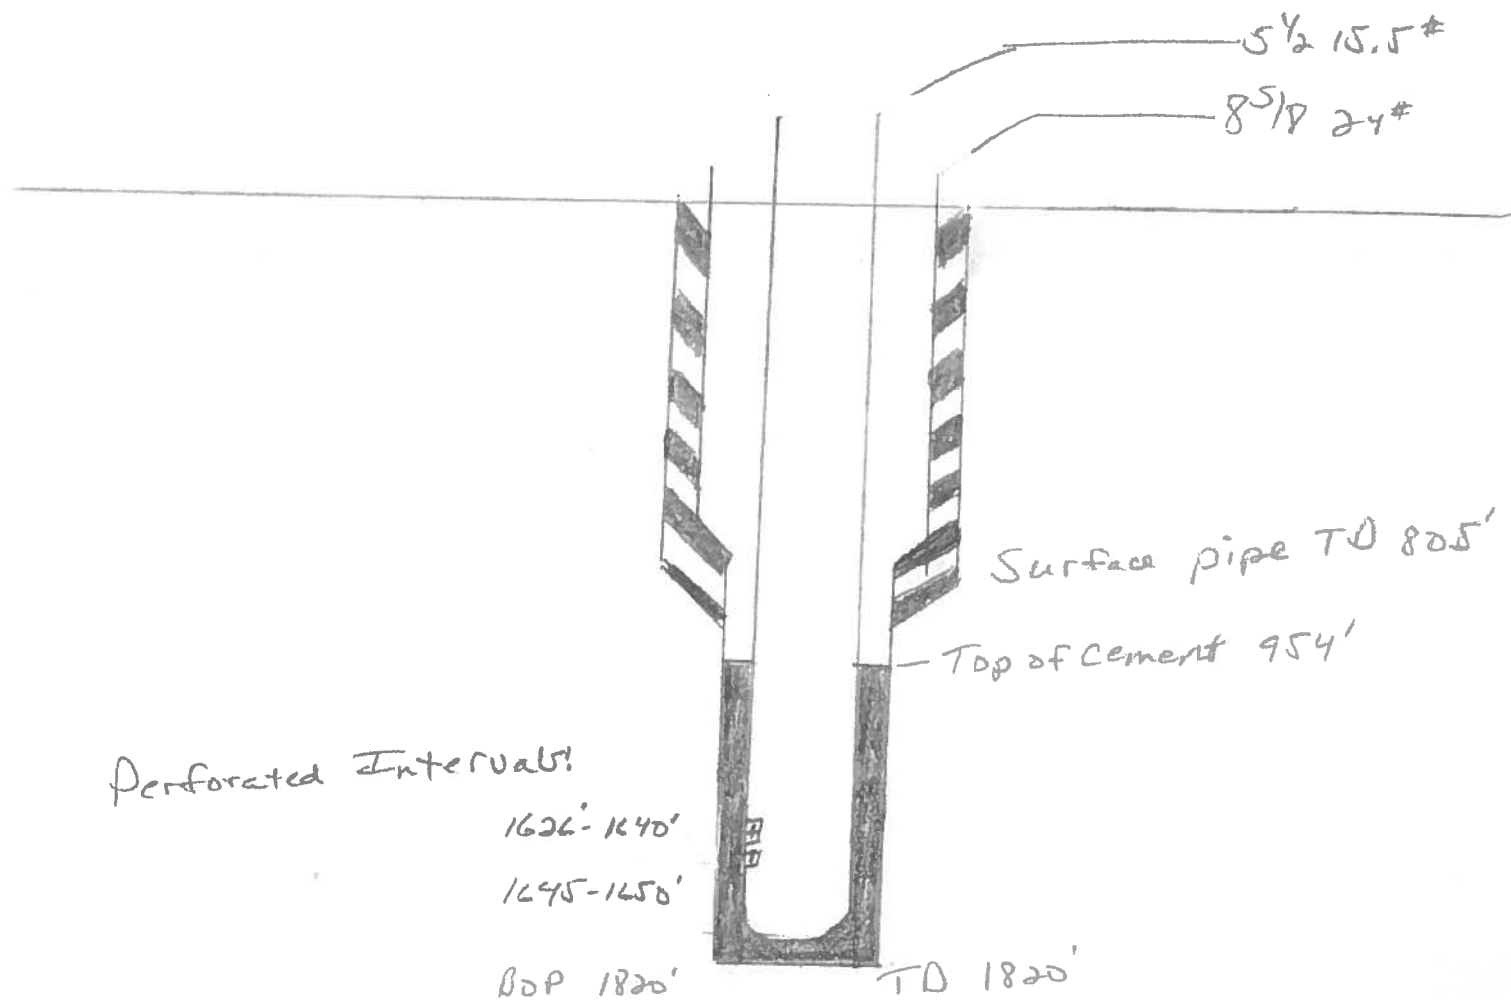

Current Configuration

Keystone 2-13  
N3/4 Sec. 13-T33S-R44W  
API # 05-009-06624-00

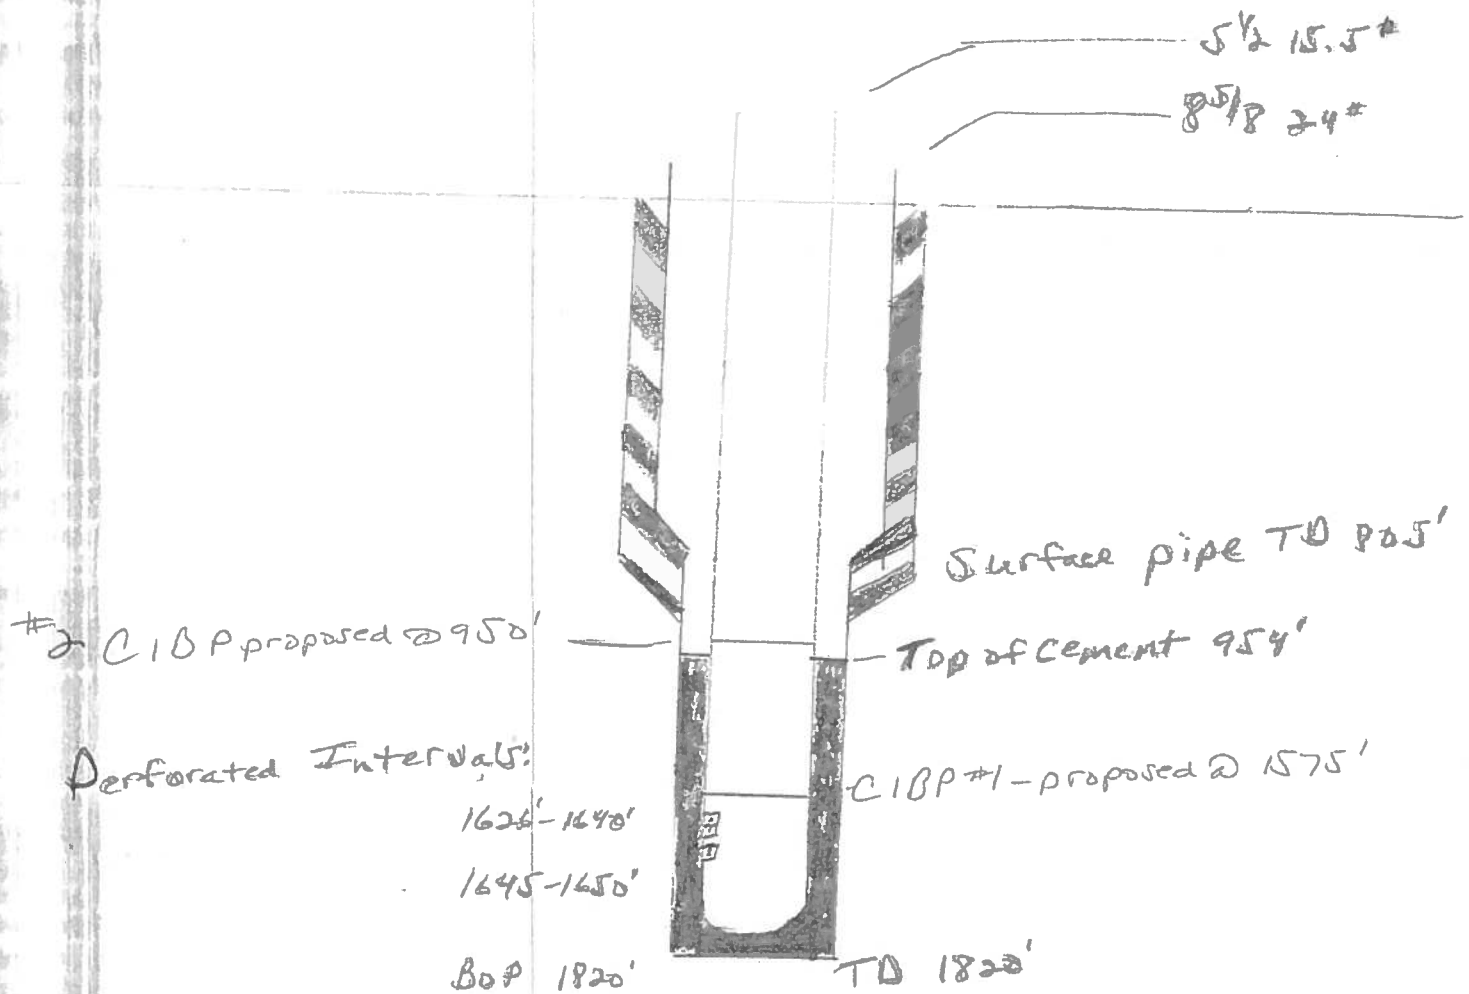

Proposed Configuration