


WPX Energy Rocky Mountain LLC
BOSELY SG 214-22
GRAND VALLEY Field
SHL 632' FSL 1526' FWL (SE/4 NW/4) Section 22 T7S R96W 6th PM
BHL 824' FSL 200' FWL (SW/4 SW/4) Section 22 T7S R96W 6th PM
Garfield County Colorado

Formation Tops
(Measured Depths)

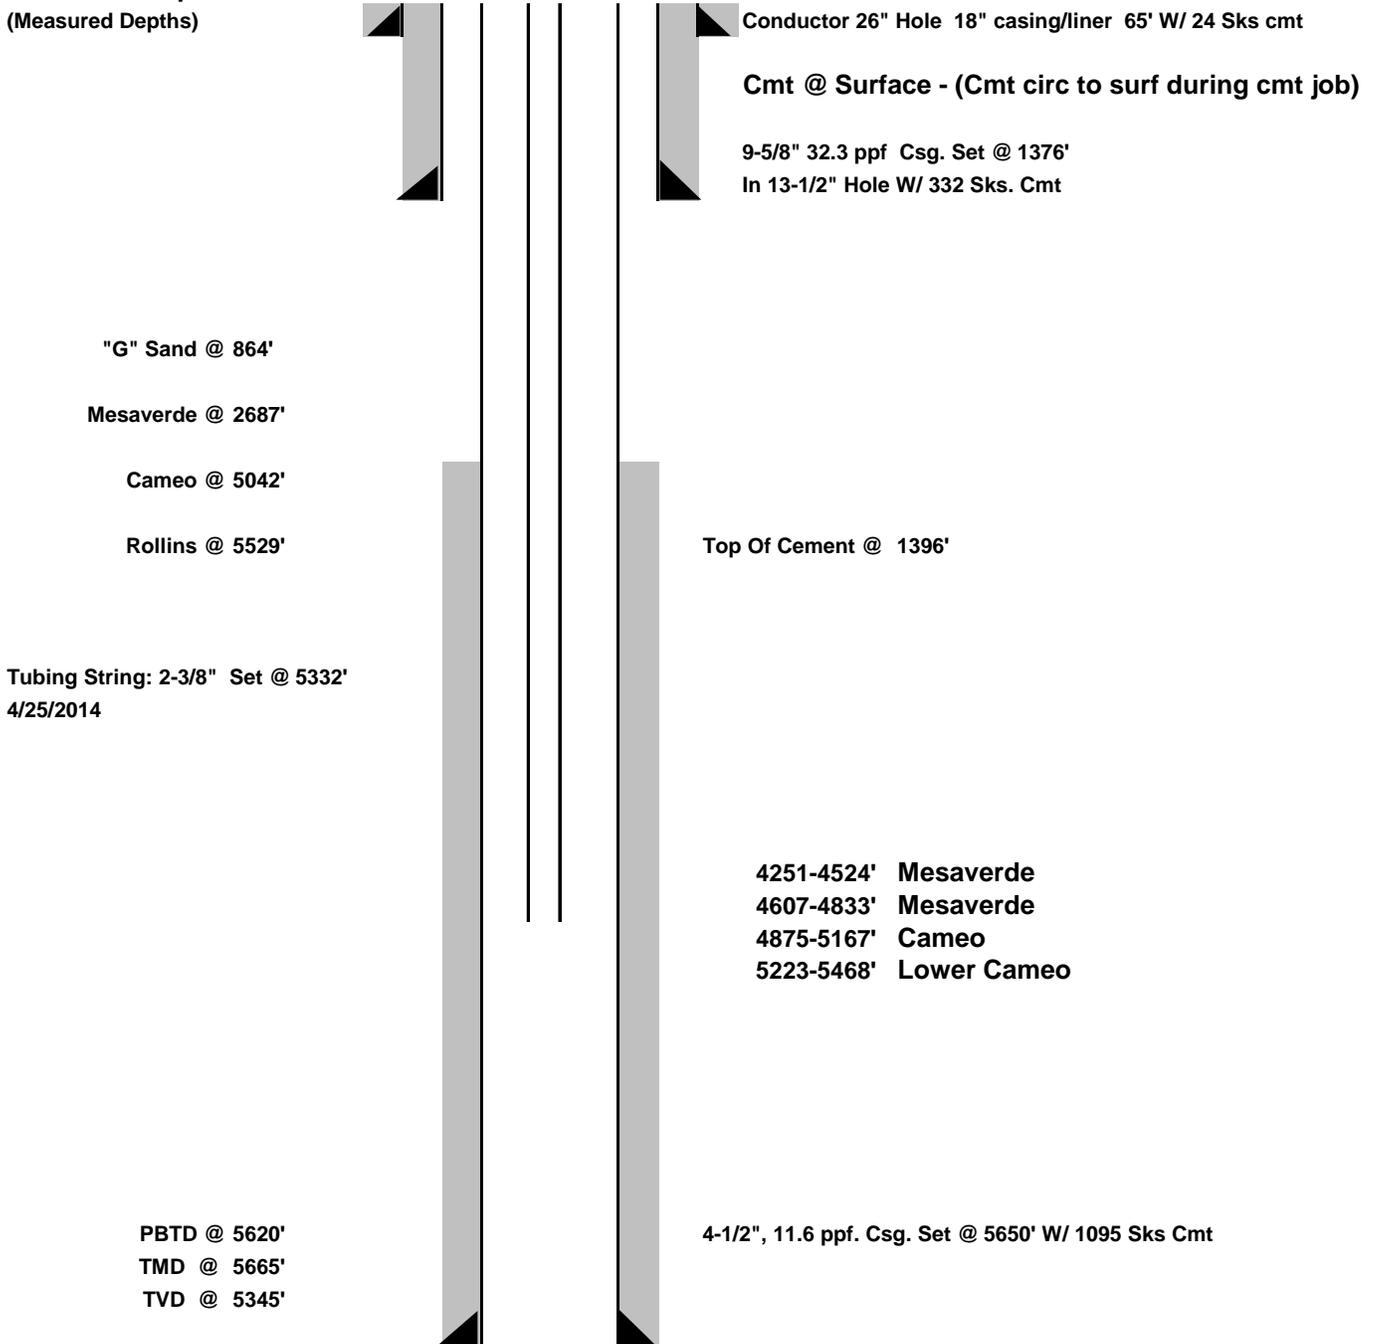

DATE CREATED: 5/5/2014

NOTE: THIS IS NOT TO SCALE.
****FINAL****