


- GP-27 Wellhead
- 1/2 Mile Radius
- GP-27 Wellpad
- GP-27 Limits of Disturbance
- Revised Driveway Access
- County Roads

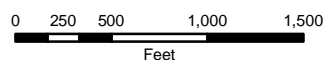

- Intermittent Stream
- Existing Oil & Gas Wells
- Montezuma County Zoning**
- A/R 10-34
- A/R 3-9
- A/R 35+
- Bureau of Land Management

1:12,000

Date: 5/13/2014

Coordinate System: NAD 1983 UTM Zone 12N

Kinder Morgan CO2

GP-27 CO2 Well

Surface Ownership

Montezuma County, CO

Sec. 18, T. 36N, R. 17W

Battle Rock, CO 1:24k