WELLBORE DIAGRAM SCHEMATIC: Box Elder H 3 5/15/2014

After P&A Schematic:

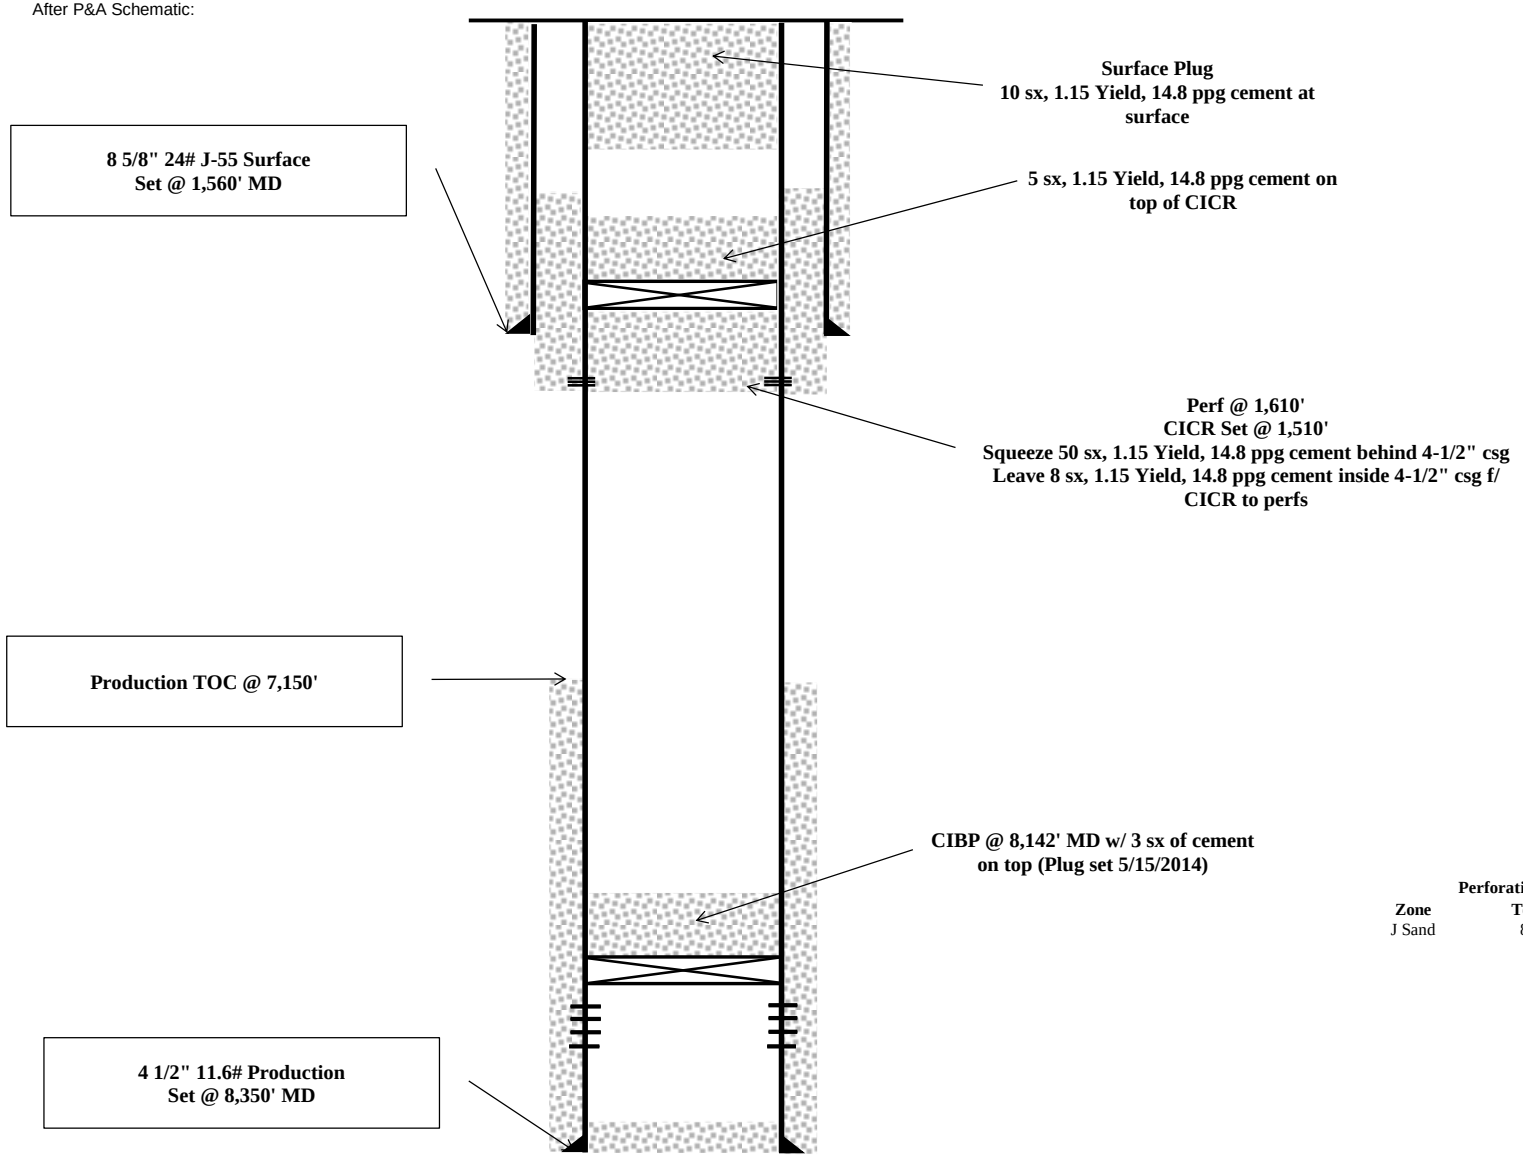

Perforation Data

Zone	Top (ft)	Bottom (ft)
J Sand	8,192	8,233