

KERR-MCGEE OIL AND GAS ONSHORE LP
ANDERSON FAMILY TRUST 1
SW SW 27 3N 68W 1,181' FSL 952' FWL
WELD,COLORADO
05/19/2014

AREA: W2

ROUTE: W23 Spud: 04/29/1971

WINS No.: 74274

AFE/WO#: 88460938

API#: 0512307308

GL: 4951

KB: 4963

MTD: 7795


TVD: 7795

LOG MD: 7798

PBMD: 7740

PBTVD: 7740

Directions: WCR 7 & WCR 28, E 2/10, N INTO

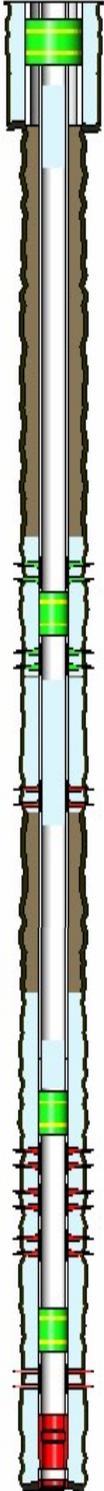

<u>HOLE SECTIONS</u>	<u>Size</u>	<u>Top</u>	<u>Btm</u>	<u>TD Date</u>					
SURFACE	12.25	12	580	05/01/1971					
PRODUCTION	7.88	580	7795	05/09/1971					
<u>TUBULARS</u>	<u>Tool Type</u>	<u>Joints</u>	<u>Size</u>	<u>Weight</u>	<u>Grade</u>	<u>Thread</u>	<u>Top D</u>	<u>Bottom D</u>	
SURFACE CASING									
	Casing	18	8.63	24	K-55	STC	12	575	
PRODUCTION CASING									
	Casing	3	4.50	11.6	K-55	STC	12	110	
	Casing	199	4.50	10.5	K-55	STC	110	6700	
	Casing	46	4.50	11.6	K-55	STC	6700	7762	
	Casing Float Collar	1	4.50				7762	7763	
	Casing	1	4.50	11.6	K-55	STC	7763	7793	
	Casing Guide Shoe	1	4.50				7793	7794	
CIBP									
	Cast Iron Bridge Plu	1	4.50				6940	6942	
CIBP									
	CIBP With CMT Cap	1	4.50				7601	7603	
CAST IRON CEMENT RETAINER									
	Cement Retainer		4.50				3912	3914	
BRIDGE PLUG									
	Cast Iron Bridge Plu		8.63				100	102	
<u>CEMENT JOBS</u>	<u>Stage</u>	<u>Sacks</u>	<u>Cement Jobs</u>	<u>Top D</u>	<u>Btm D</u>	<u>cbl</u>			
SURFACE CASING									
	STAGE 1	300	50/50 POZ-MIX	12	400	No			
	STAGE 1 TAIL	150	G	400	580	No			
PRODUCTION CASING									
	PRIM CMT 1ST STAGE	200	LEAD 50/50 Poz	7235	7794	Yes			
PRODUCTION CASING									
	REMEDIAL CEMENT	175	LEAD 50/50 POZ-MIX	4010	4600	Yes			
	REMEDIAL CEMENT	50	TAIL G	4600	4805	Yes			
	REMEDIAL CEMENT	150	50/50 POZ-MIX	6190	7235	Yes			
PRODUCTION CASING									
	ABANDONMENT PLUC	25	LEAD FRESH WATER	6545	6925	No			
PRODUCTION CASING									
	ABANDONMENT PLUC	70	LEAD FRESH WATER	4018	4900	No			
PRODUCTION CASING									
	ABANDONMENT PLUC	80	LEAD FRESH WATER	3720	3981	No			
PRODUCTION CASING									
	ABANDONMENT PLUC	200	LEAD FRESH WATER	268	895	No			
<u>PERFORATIONS</u>	<u>Formation</u>	<u>Zone</u>	<u>Top</u>	<u>Btm</u>	<u>Date</u>	<u>Reason</u>	<u>Comments</u>		
			3880	3881	04/22/2014	CEMENT SQUEEZE			
			3980	3981	04/22/2014	CEMENT SQUEEZE			
			4800	4801	03/04/2005	CEMENT SQUEEZE			
	NIOBRARA	B	7000	7006	02/16/2010	PRODUCTION	Under 2 CIBPs & abn plug		
	NIOBRARA	C	7090	7100	02/16/2010	PRODUCTION			
	CODELL		7223	7243	03/08/2005	PRODUCTION	3 SPF		
	J SAND		7661	7691	05/27/1971	PRODUCTION	2 SPF		

KERR-MCGEE OIL AND GAS ONSHORE LP
ANDERSON FAMILY TRUST 1
SW SW 27 3N 68W 1,181' FSL 952' FWL
WELD,COLORADO
05/19/2014

AREA: W2 ROUTE: W23 Spud: 04/29/1971 WINS No.: 74274 AFE/WO#: 88460938 API#: 0512307308

GL: 4951 KB: 4963 MTD: 7795 TVD: 7795 LOG MD: 7798 PBMD: 7740 PBTVD: 7740

Directions: WCR 7 & WCR 28, E 2/10, N INTO

Comments: