

Daily Operations Report


Wellbore Diagram

Well Name:	Jacks Draw 13
County, State	Moffat, CO
Legal Description:	NW SW 22-12N-97W
API:	05-081-06165
SHL:	2310' FSL, 330' FWL
BHL Relative to SHL:	0' N, 0' E
Updated By:	Jeff Bluemel
Date Updated:	4/16/2014
Spud Date:	4/17/1972
TD Date:	5/8/1972
IP Date:	6/3/1972
Well TD:	6,500
Well TVD:	6,500
Orientation:	Vertical
Plug Back MD:	5,490
Bridge Plug MD:	5,814
Producing Frac Jobs:	1

Latitude	40.984865
Longitude	-108.285927

As Of Completion	5/27/1972
------------------	-----------

All measurements are in KB
unless otherwise specified.

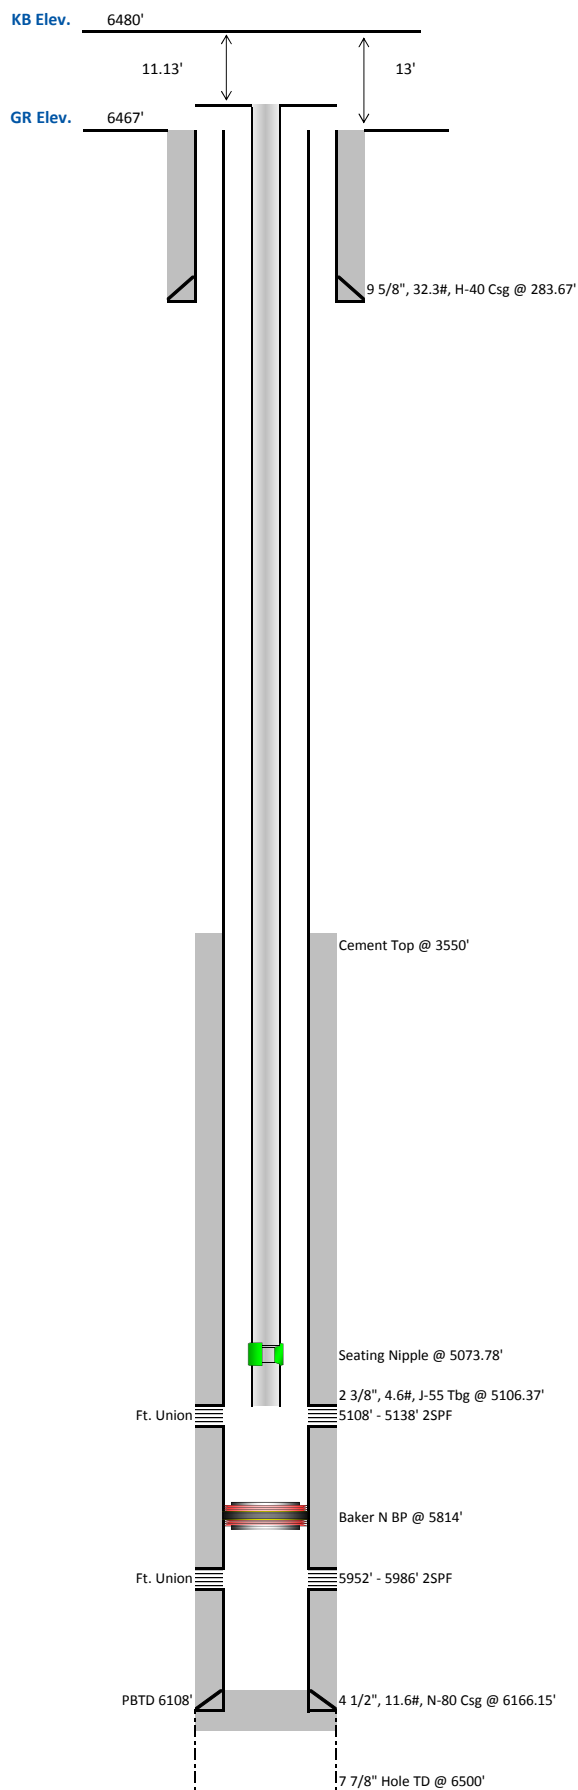

Daily Operations Report

Wellbore Diagram

Well Name:	Jacks Draw 13
County, State	Moffat, CO
Legal Description:	NW SW 22-12N-97W
API:	05-081-06165
SHL:	2310' FSL, 330' FWL
BHL Relative to SHL:	0' N, 0' E
Updated By:	Chris Beilby
Date Updated:	4/16/2014
Spud Date:	4/17/1972
TD Date:	5/8/1972
IP Date:	6/3/1972
Well TD:	6,500
Well TVD:	6,500
Orientation:	Vertical
Plug Back MD:	Surface
Bridge Plug MD:	5,814
Producing Frac Jobs:	None

Latitude	40.984865
Longitude	-108.285927

As Of Plug & Abandon	Pending
---------------------------------	---------

All measurements are in KB
unless otherwise specified.

