


The diagram shows a circular landscape. A central square is labeled 'B' above it. To the right of the square, the word 'grassland' is written. A vertical line runs from the top to the bottom of the circle. Along this line, there are three points marked with black dots. The top point is labeled 'C' to its right and 'PP' above it. The middle point is labeled 'D' to its left and 'PP' above it, with 'E' below it. The bottom point is labeled 'F' to its right and 'PP' above it. The letter 'A' is located to the left of the bottom point. The vertical line is divided into three segments by these points, each labeled 'OHP' to its left.



PP Power pole

———— OHP ————— Power line

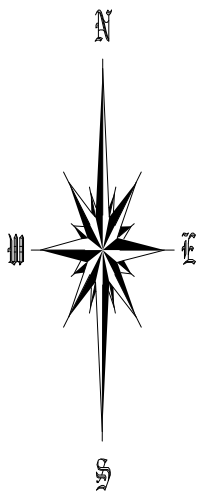

F = Power pole approx. 444' SW



53575 County Road NN
Wray, CO 80758
(970) 466-0552
fortynorthllc@gmail.com

SW1/4 SE1/4 SEC. 35, T1S, R44W, 6PM, Yuma County, Colo.