

KERR-MCGEE OIL AND GAS ONSHORE LP
DRY CREEK 22-35
SE NW 35 1N 67W 2,159' FNL 2,095' FWL
WELD,COLORADO
05/01/2014

AREA: W3

ROUTE: W34 Spud: 01/09/2011

WINS No.: C7042

AFE/WO#: 88476937

API#: 0512331115

GL: 5006

KB: 5021

MTD: 8422


TVD: 8315

LOG MD: 8396

PBMD: 8382

PBTVD: 8275

Directions: WCR 2 & WCR 21, N 3/10, SE 200', E 1/10, N 3/10, E 1/10 INTO

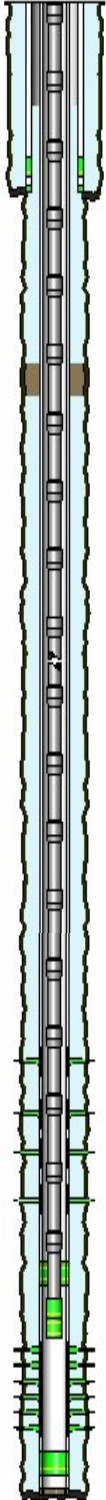

<u>HOLE SECTIONS</u>		<u>Size</u>	<u>Top</u>	<u>Btm</u>	<u>TD Date</u>			
SURFACE		12.25	15	1201	01/10/2011			
PRODUCTION		7.88	1201	8422	01/13/2011			
<u>TUBULARS</u>	<u>Tool Type</u>	<u>Joints</u>	<u>Size</u>	<u>Weight</u>	<u>Grade</u>	<u>Thread</u>	<u>Top D</u>	<u>Bottom D</u>
SURFACE CASING	Casing	26	8.63	24.00	J-55	STC	15	1145
	Baffle	1	8.63		J-55		1145	1145
	Casing	1	8.63	24.00	J-55	STC	1145	1190
	Saw Tooth Shoe	1	8.63		J-55		1190	1191
PRODUCTION CASING	Casing	186	4.50	11.60	I-80	LTC	15	8161
	Frac Baffle	1	4.50		I-80		8161	8161
	Casing	5	4.50	11.60	I-80	LTC	8161	8382
	Latch Down Baffle	1	4.50		I-80		8382	8382
	Casing	1	4.50	11.60	I-80	LTC	8382	8410
	Casing Float Shoe	1	4.50		I-80		8410	8412
PRODUCTION TUBING	Tubing	261	2.37	4.70	J-55	External-Ups	15	8261
	XN Profile Nipple	1	2.38				8261	8262
	Notched Collar	1	2.38				8262	8263
<u>CEMENT JOBS</u>	<u>Stage</u>	<u>Sacks</u>	<u>Cement Jobs</u>		<u>Top D</u>	<u>Btm D</u>	<u>cbl</u>	
SURFACE CASING	PRIM CMT 1ST STAGE	750	TAIL	TYPE 3	15	1201	No	
PRODUCTION CASING	PRIM CMT 1ST STAGE	745	LEAD	ECONOCEM	2690	6900	Yes	
	PRIM CMT 1ST STAGE	235	TAIL	FRACEM	6900	8411	Yes	
PRODUCTION CASING	ONE INCH JOB	350	LEAD	FRESH WATER	764	2440	Yes	
<u>PERFORATIONS</u>								
<u>Formation</u>	<u>Zone</u>	<u>Top</u>	<u>Btm</u>	<u>Date</u>	<u>Reason</u>	<u>Comments</u>		
NIOBRARA	A	7422	7430	04/04/2011	PRODUCTION	Bob G		
NIOBRARA	B	7604	7614	04/04/2011	PRODUCTION			
NIOBRARA	C	7692	7698	04/04/2011	PRODUCTION			
CODELL		7838	7852	03/30/2011	PRODUCTION			
J SAND		8288	8294	03/17/2011	PRODUCTION			
J SAND		8302	8312	03/17/2011	PRODUCTION			
J SAND		8314	8320	03/17/2011	PRODUCTION			

Comments: