WPXENERGY

Well Name: PA 522-2
Surface Location: GV 86-2 Pad
North American Datum 1983 , US State Plane 1983 , Colorado Central Zone
Ground Elevation: 5821.0

+N/-S	+E/-W	Northing	Easting	Latittude	Longitude	Slot
0.0	0.0	1603780.10	2302930.30	39.46514	-107.96934	B3
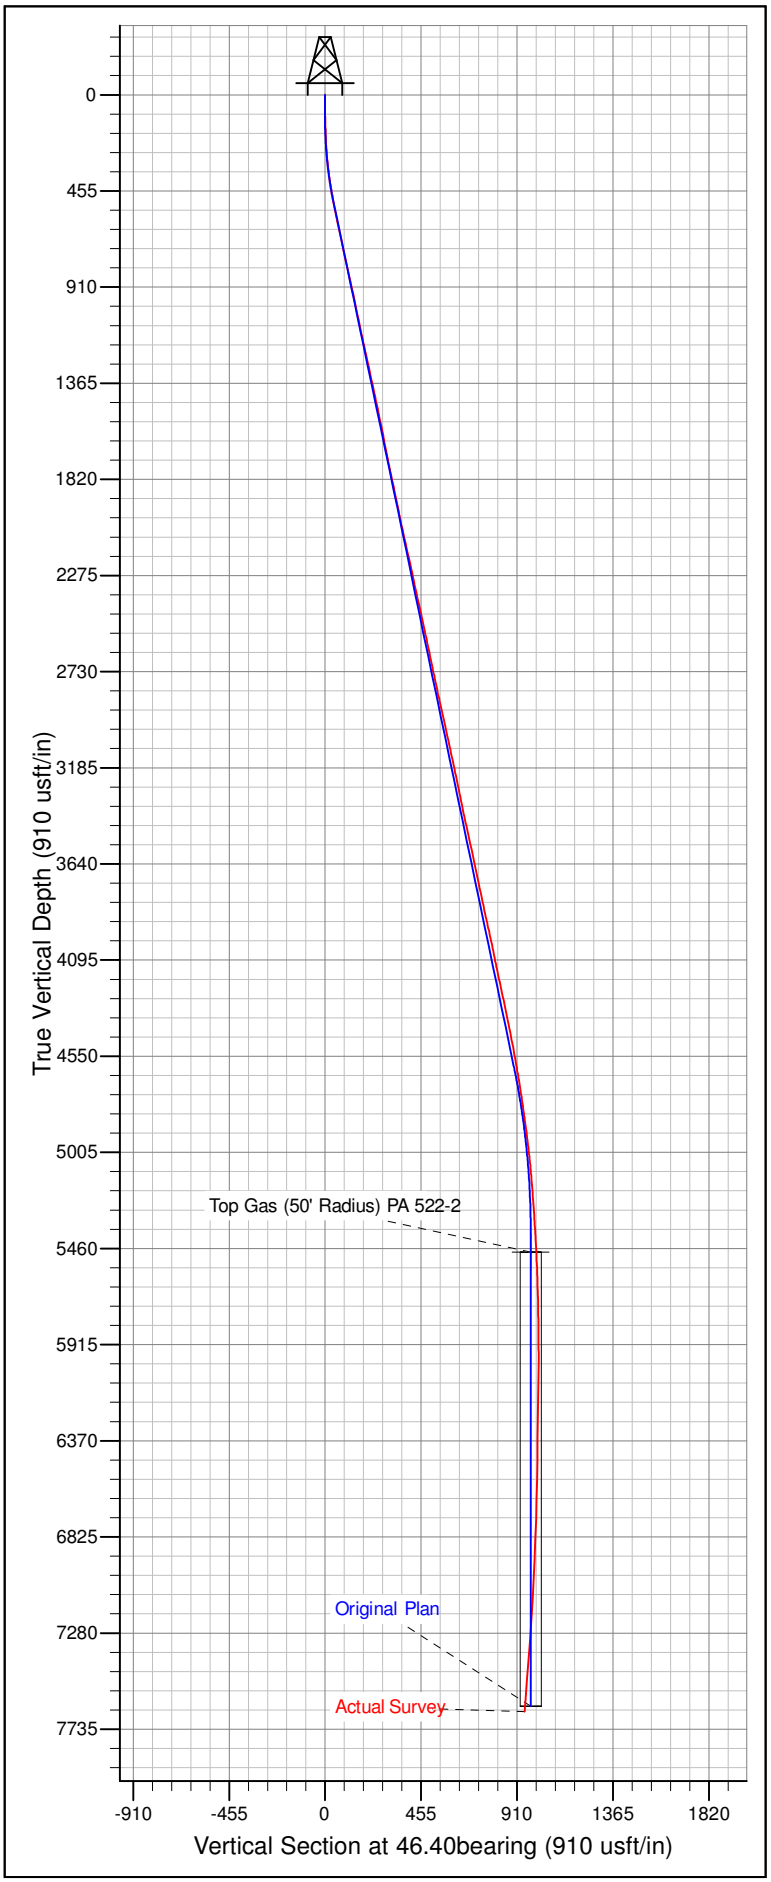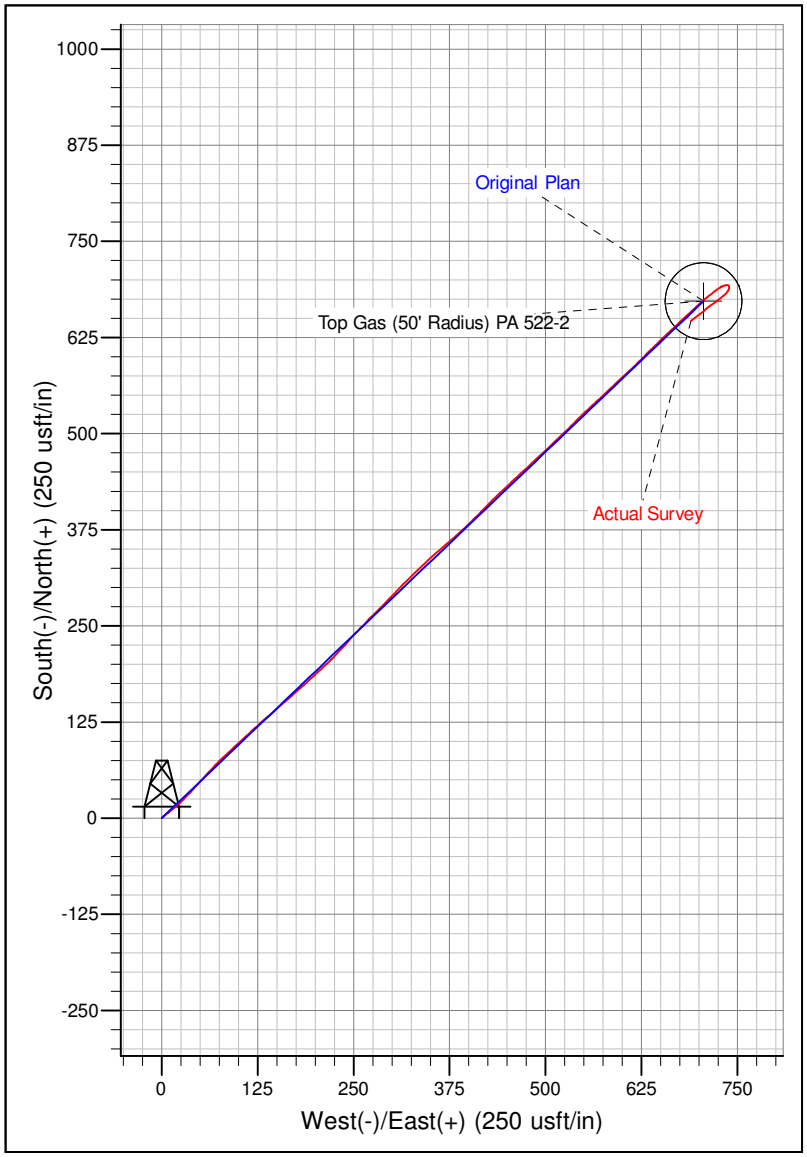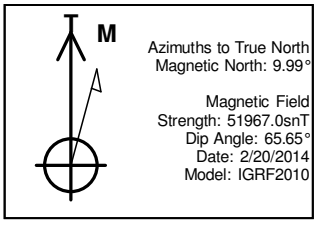
KB @ 5846.0usft (Aztec 1000)