


WELL LOCATION CERTIFICATE

THIS MAP DOES NOT REPRESENT A BOUNDARY SURVEY

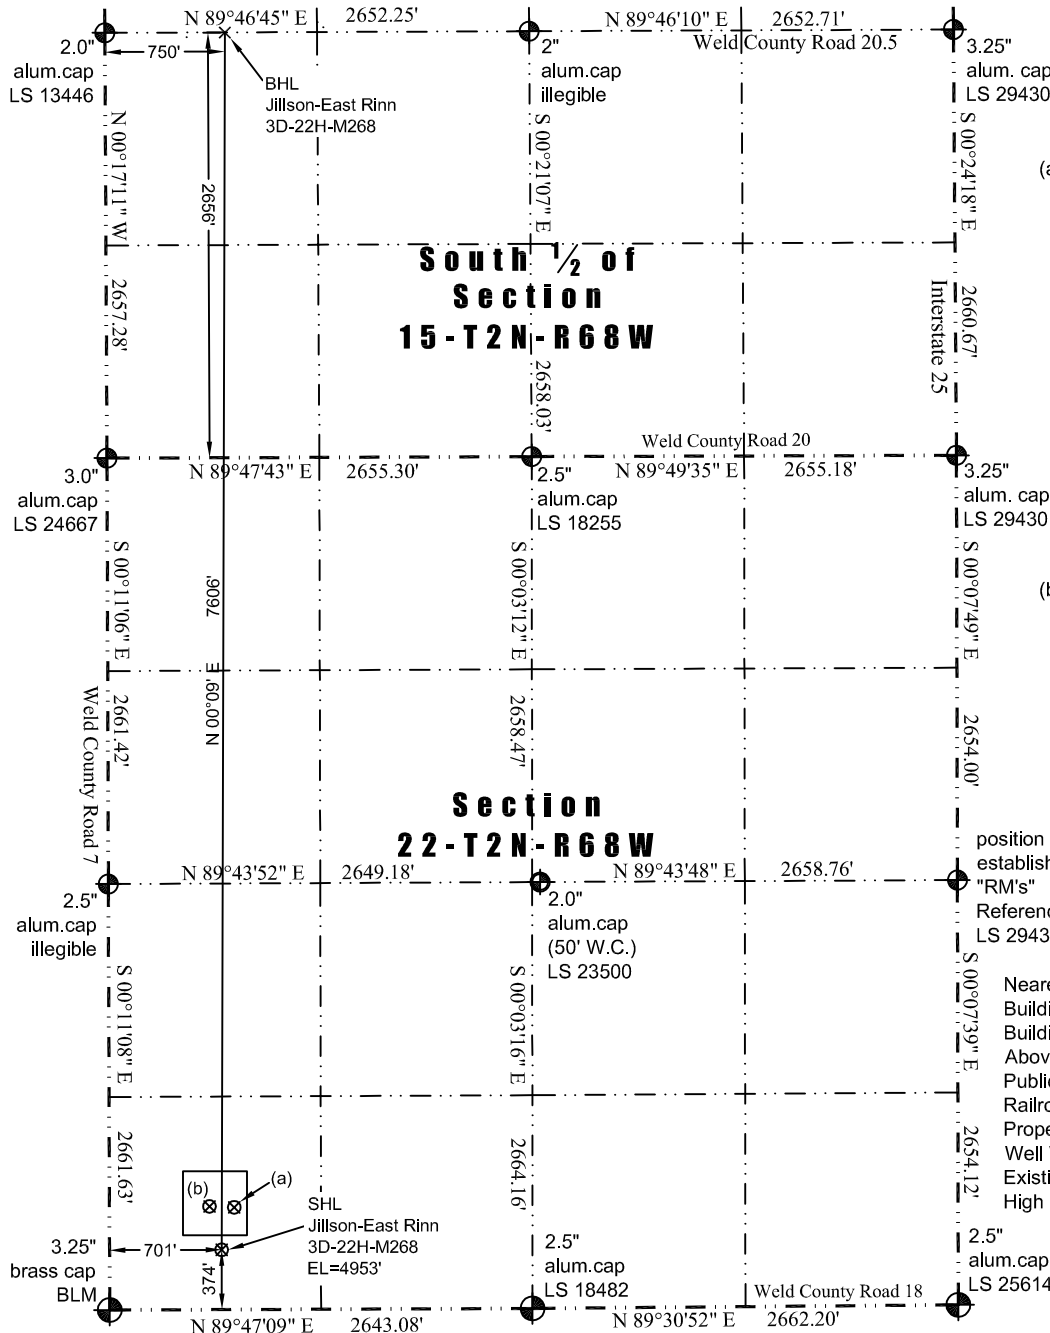


Washburn Land Surveying
www.WashburnSurveying.com
970-232-9645



(a) Existing Well Data:
Jillson 14-22
Latitude: N 40.11862°
Longitude: W 104.99613°
FSL: 632'
FWL: 741'
ELEV: 4950'
PDOP: 2.0

(b) Existing Well Data:
Jillson #3
Latitude: N 40.11863°
Longitude: W 104.99644°
FSL: 636'
FWL: 655'
ELEV: 4951'
PDOP: 2.0

position established by "RM's"
Reference Markers LS 29430
Nearest:
Building: 989' southwest
Building Unit: 989' southwest
Above Ground Utility: 347' south
Public Road: 361' south
Railroad: +5,280
Property Line: 374' south
Well Window: SHL is 92' outside
Existing Well: Jillson 14-22, 262' northeast
High Occupancy Building Unit: 3,393' southeast

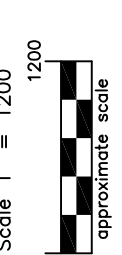

LEGEND
- found survey monument
- calculated dimension

In accordance with a request from Jay Knutson of EnCana Oil & Gas (USA) Inc., Washburn Land Surveying, LLC has determined the location of the **Jillson-East Rinn 3D-22H-M268** well site to be SHL: 374' FSL and 701' FWL, (BHL: 2656' FSL and 750' FWL), as measured at ninety (90) degrees from the section lines of Sections 15 and 22, Township 2 North, Range 68 West of the 6th Principal Meridian, Weld County Colorado.

Proposed Surface Hole Data:

Latitude: N 40.117908° (BHL: 40.138786°)
Longitude: W 104.996277° (BHL: 104.996052°)
PDOP: 1.9

Notes:

- 1) Bearings and distances based on NAD 83 Colorado North State Plane Coordinate, using RTK GPS observations taken 4/25/14 by operator Chris Bettencourt.
- 2) Conversion factor to ground (1.000285153).
- 3) Elevations based on NAVD 88 GPS heights and Geoid 2009 corrections.
- 4) See Location Drawing for visible improvements within 500 feet of Pad Site.
- 5) The surface use is a cultivated field.

NOTICE: According to Colorado law you must commence any legal action based upon any defect in this W.L.C. within three years after you first discover such defect. In no event may any action based upon any defect in this W.L.C. be commenced more than ten years from this said date of the certification shown hereon.

I hereby certify that this Well Location Certificate was prepared by me or under my direct supervision on 4/26/2014 for and on behalf of EnCana Oil & Gas (USA) Inc. That it is not a Land Survey Plat or an Improvement Survey Plat and that it is not to be relied upon for establishment of fences, buildings, or other future improvement lines.

John Robert McGehee LS#38219
Well: Jillson-East Rinn 3D-22H-M268 WLC