

Hill #3-10

Latitude/Longitude: N40.33936000, W -104.74682000:


Township/Range: 2 004-N

Nesw, Sec. 2, T4N-R66W, Weld Co., Co

County: Weld, State: CO

Spud Date: 11/18/1983

Total Depth: 7310

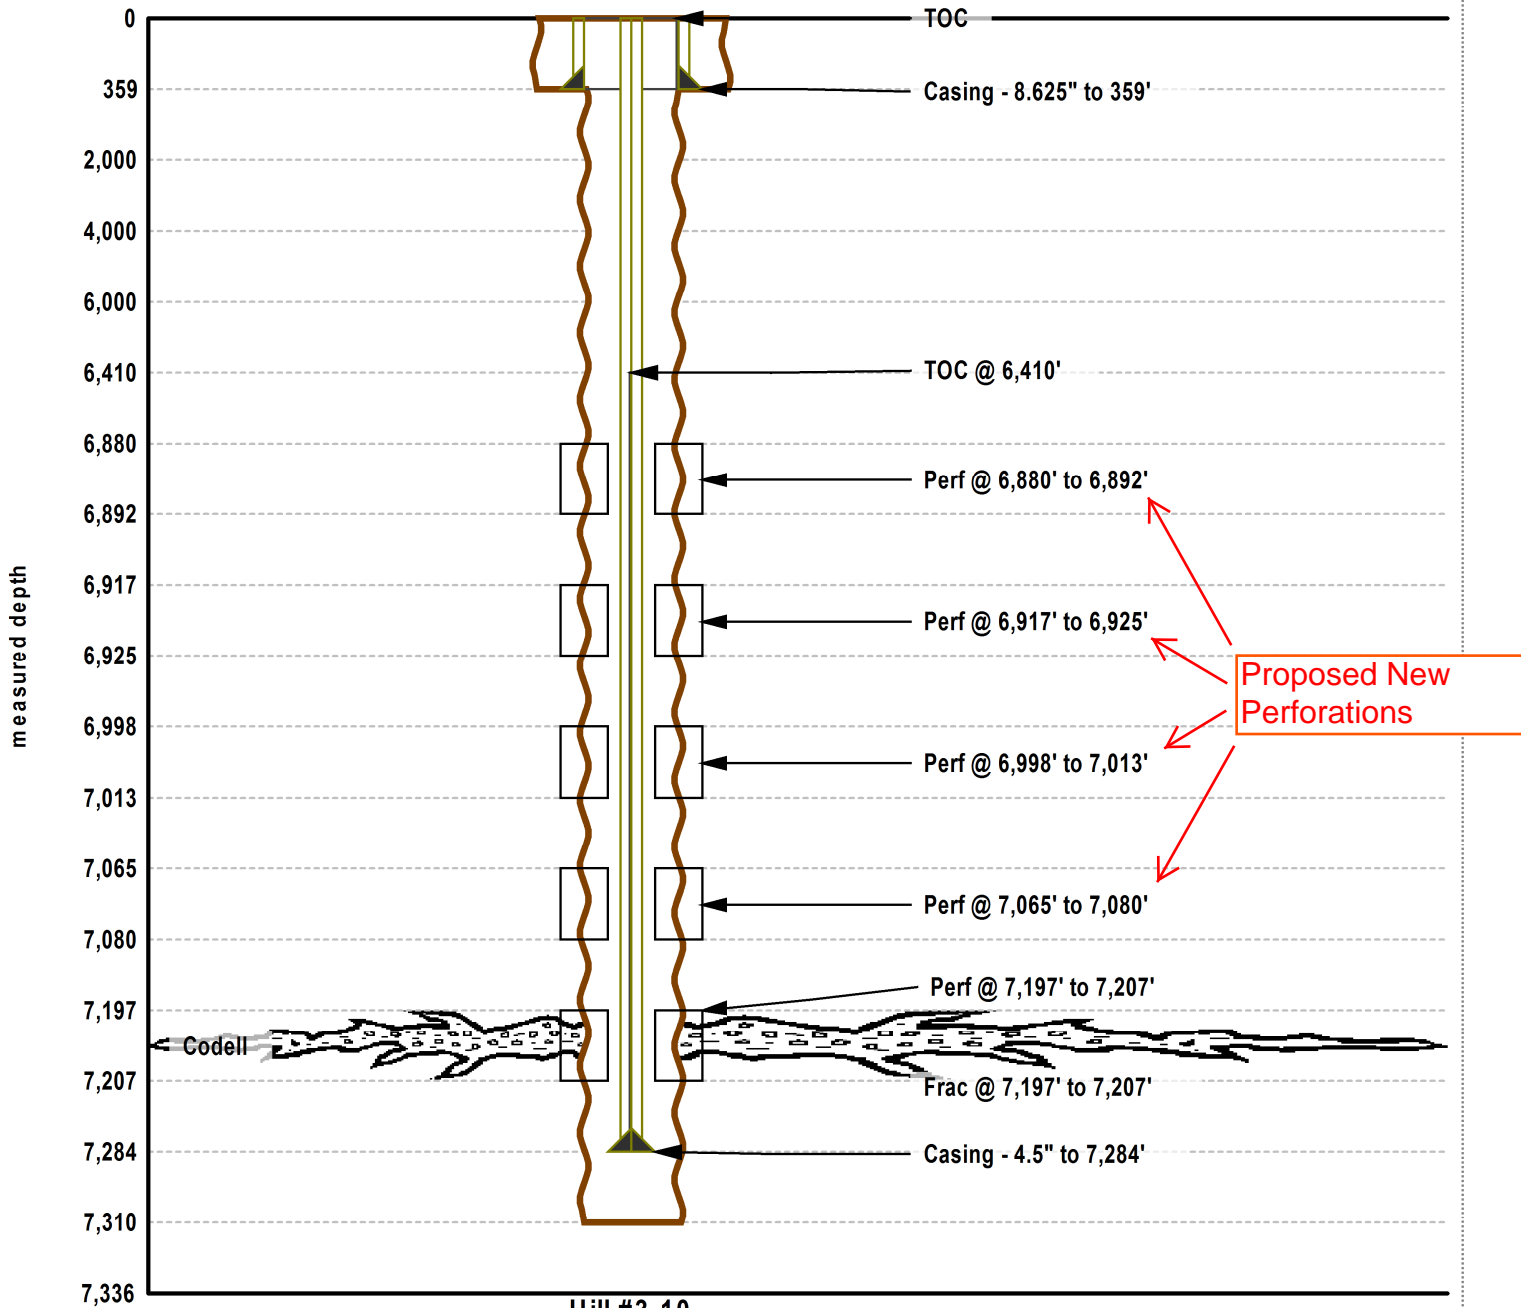

Hill #3-10

Initial Completion: 12/7/1983

Proposed Depth: 0 Plug Back Depth: 7260